




Weston is the origin of the coordinate system.
 All azimuths are referred to true South.
 Grid divergence as shown.
 Elevations are referred to mean sea level.
 Topography taken from survey of 1932 & aerial photographic survey of October, 1938.

**MISSOURI RIVER
SANDY POINT - BLAIR BENDS
CONSTRUCTION MAP
MILE 704.55 TO MILE 692.55**

In Sheets _____ Sheet No. _____ Scale 1"=400'
 U.S. Engineer Office, Omaha, Nebraska February, 1940
 Submitted: _____ Approved: _____
 Compiled by _____ Traced by _____ Checked by _____ Transmitted with _____ File No. _____
 F.H. F.H. A.W.K. dated _____ A-4-13

Note: Revetment alignment shown does not entirely conform to Revetment as constructed. For alignment of top of bank see drawing of Area Engineer dated June 4, 1940 File A-2-75. No date available for alignment of CRP line.

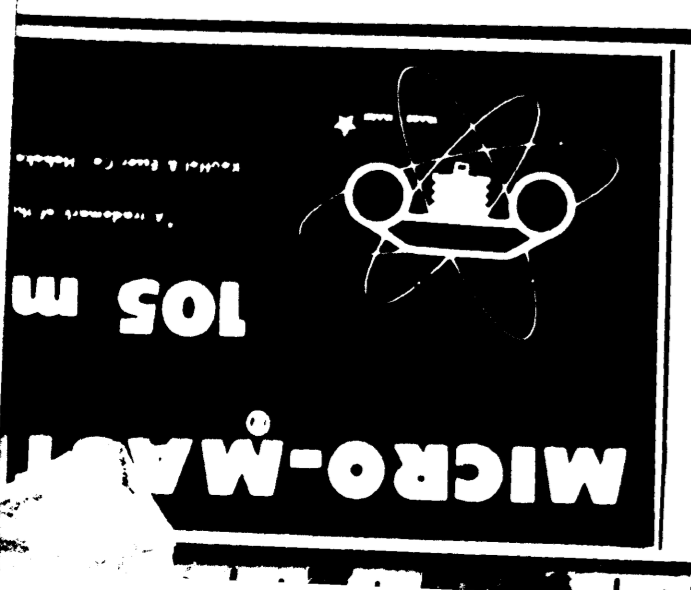

1966
 JAMES W. HARRIS
 ARCHITECTS & ENGINEERS
 1001 S. 10th Street
 Omaha, Nebraska

Blue Print Company
 1415 MARKET STREET
 OMAHA, NEBR.

ART MATERIALS
 ARCHITECTS &
 ENGINEERS
 PHOTO COPY &
 REDUCTIONS
 BLUEPRINTING
 OMAHA, NEBR.