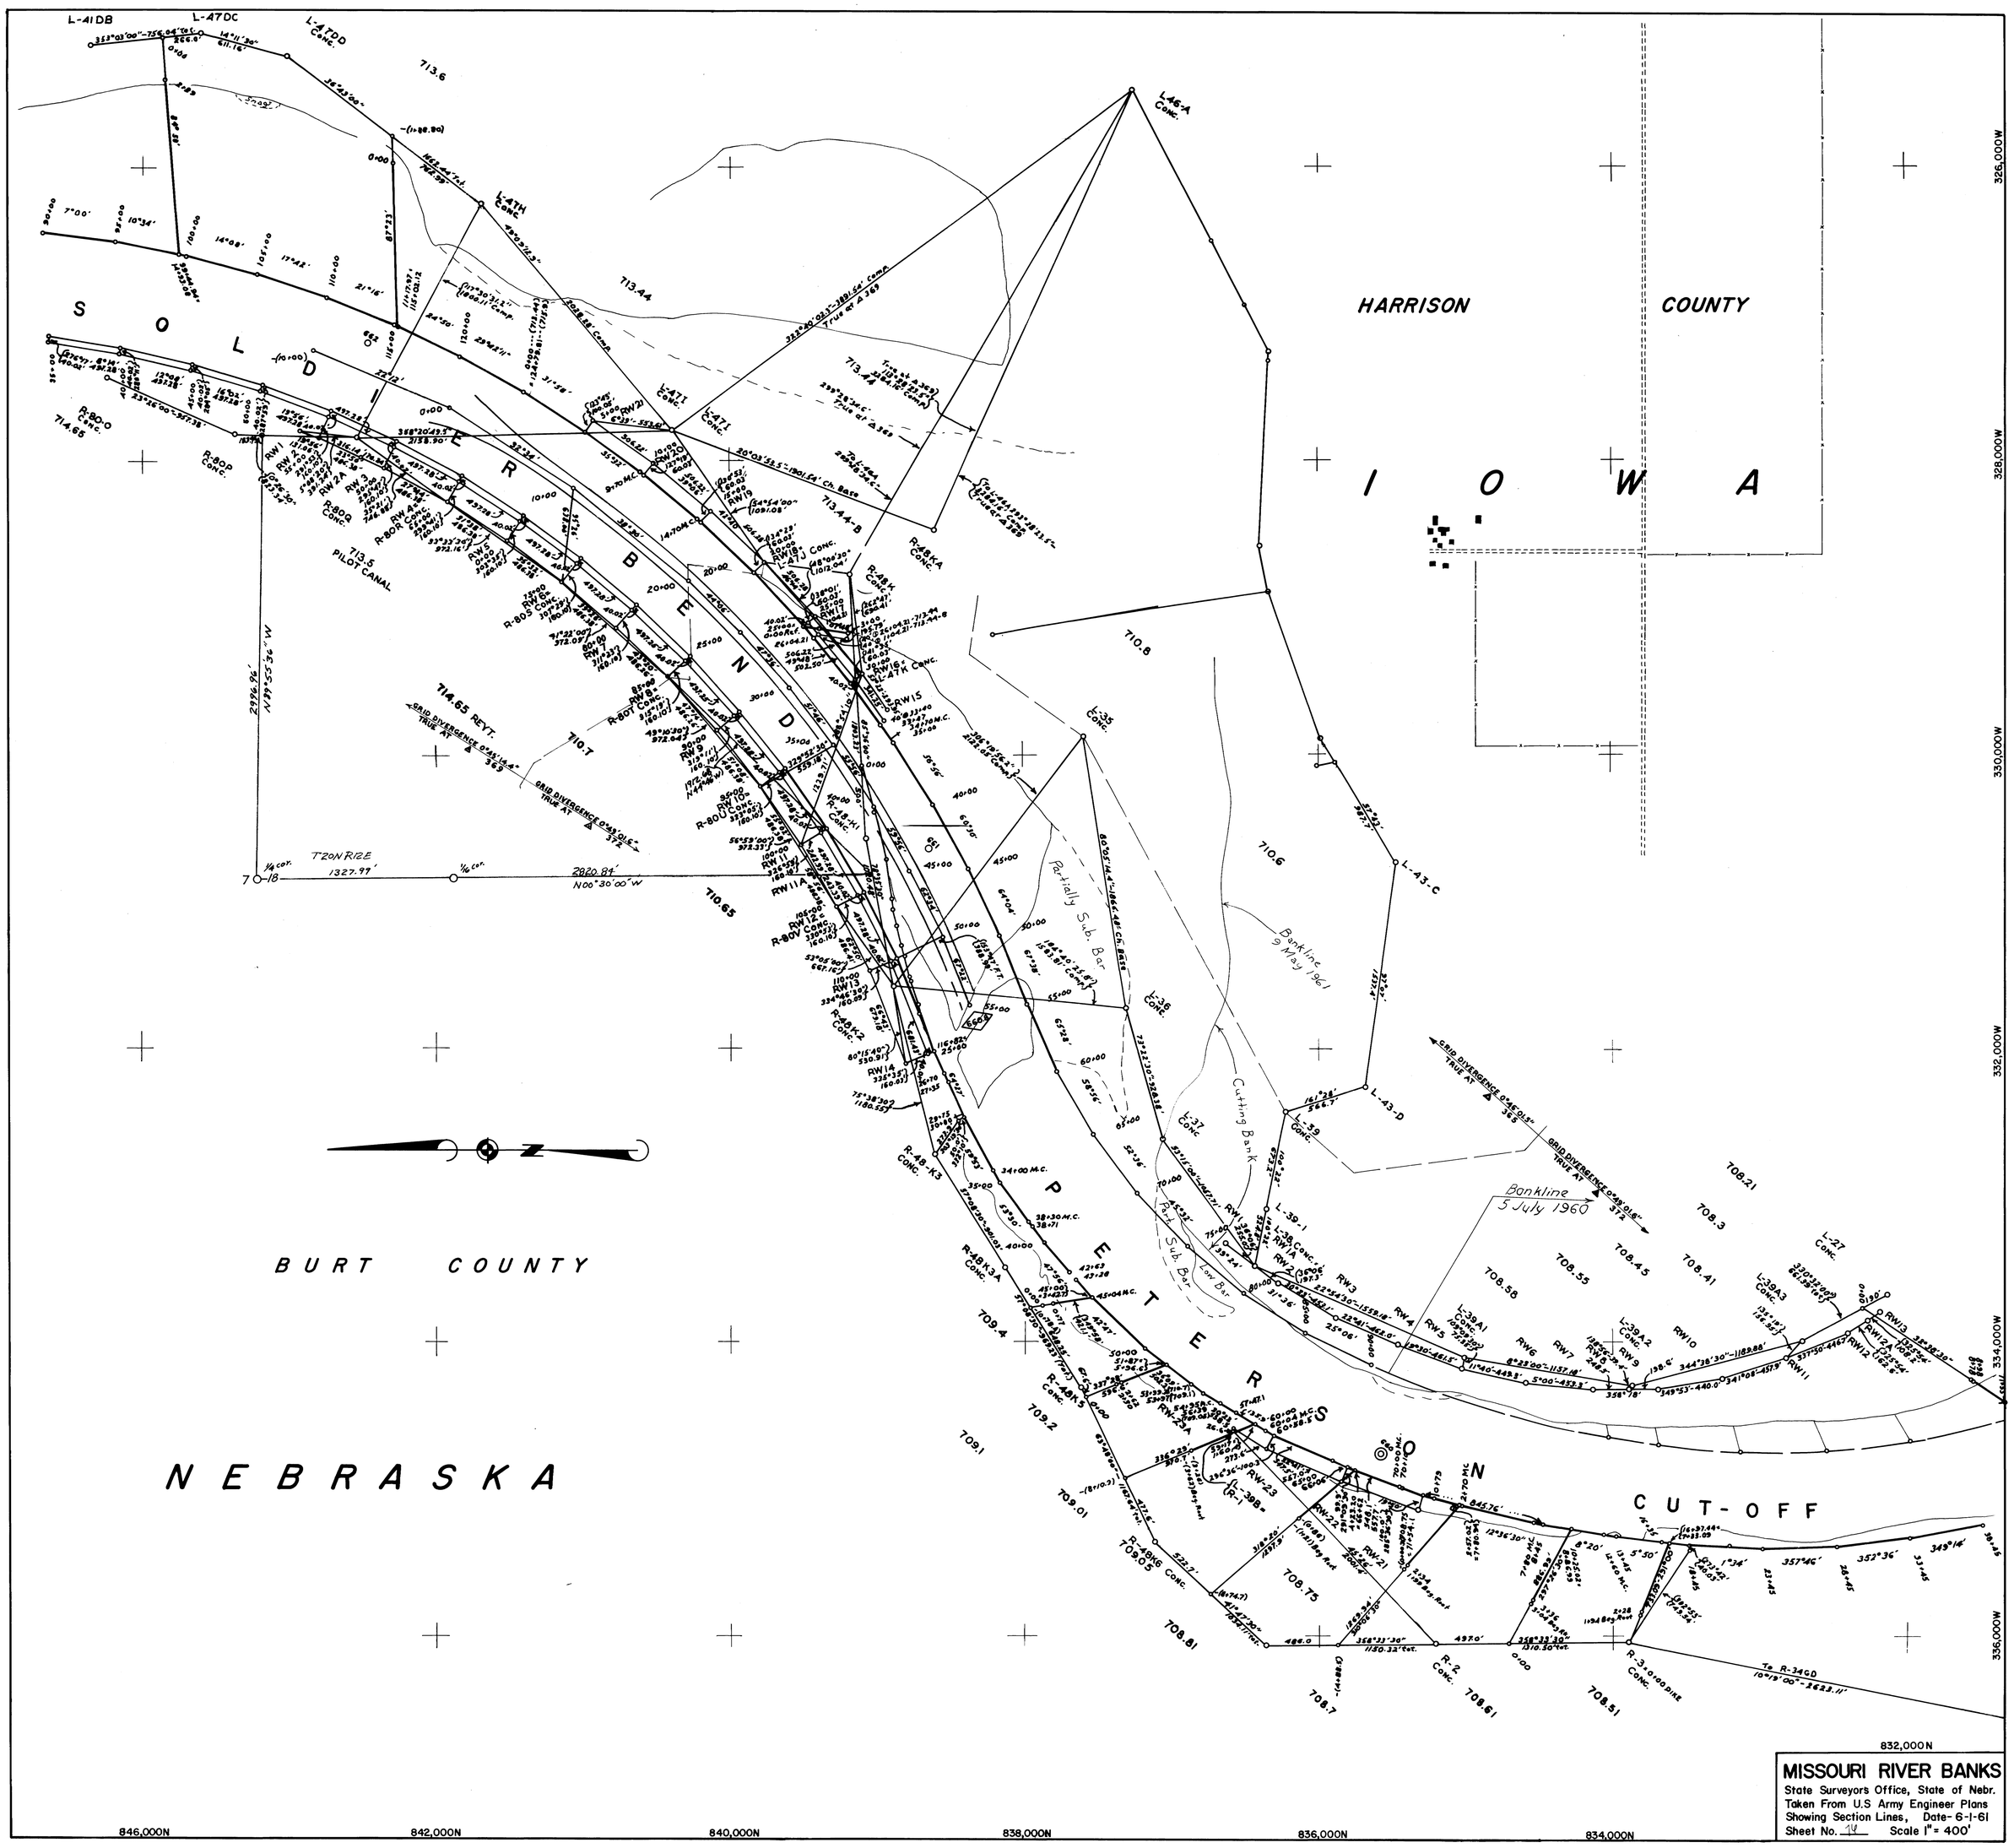

MISSOURI RIVER BANKS
State Surveyors Office, State of Nebr.
Taken From U.S Army Engineer Plans
Showing Section Lines, Date- 6-1-61
Sheet No. 19 Scale 1" = 400'

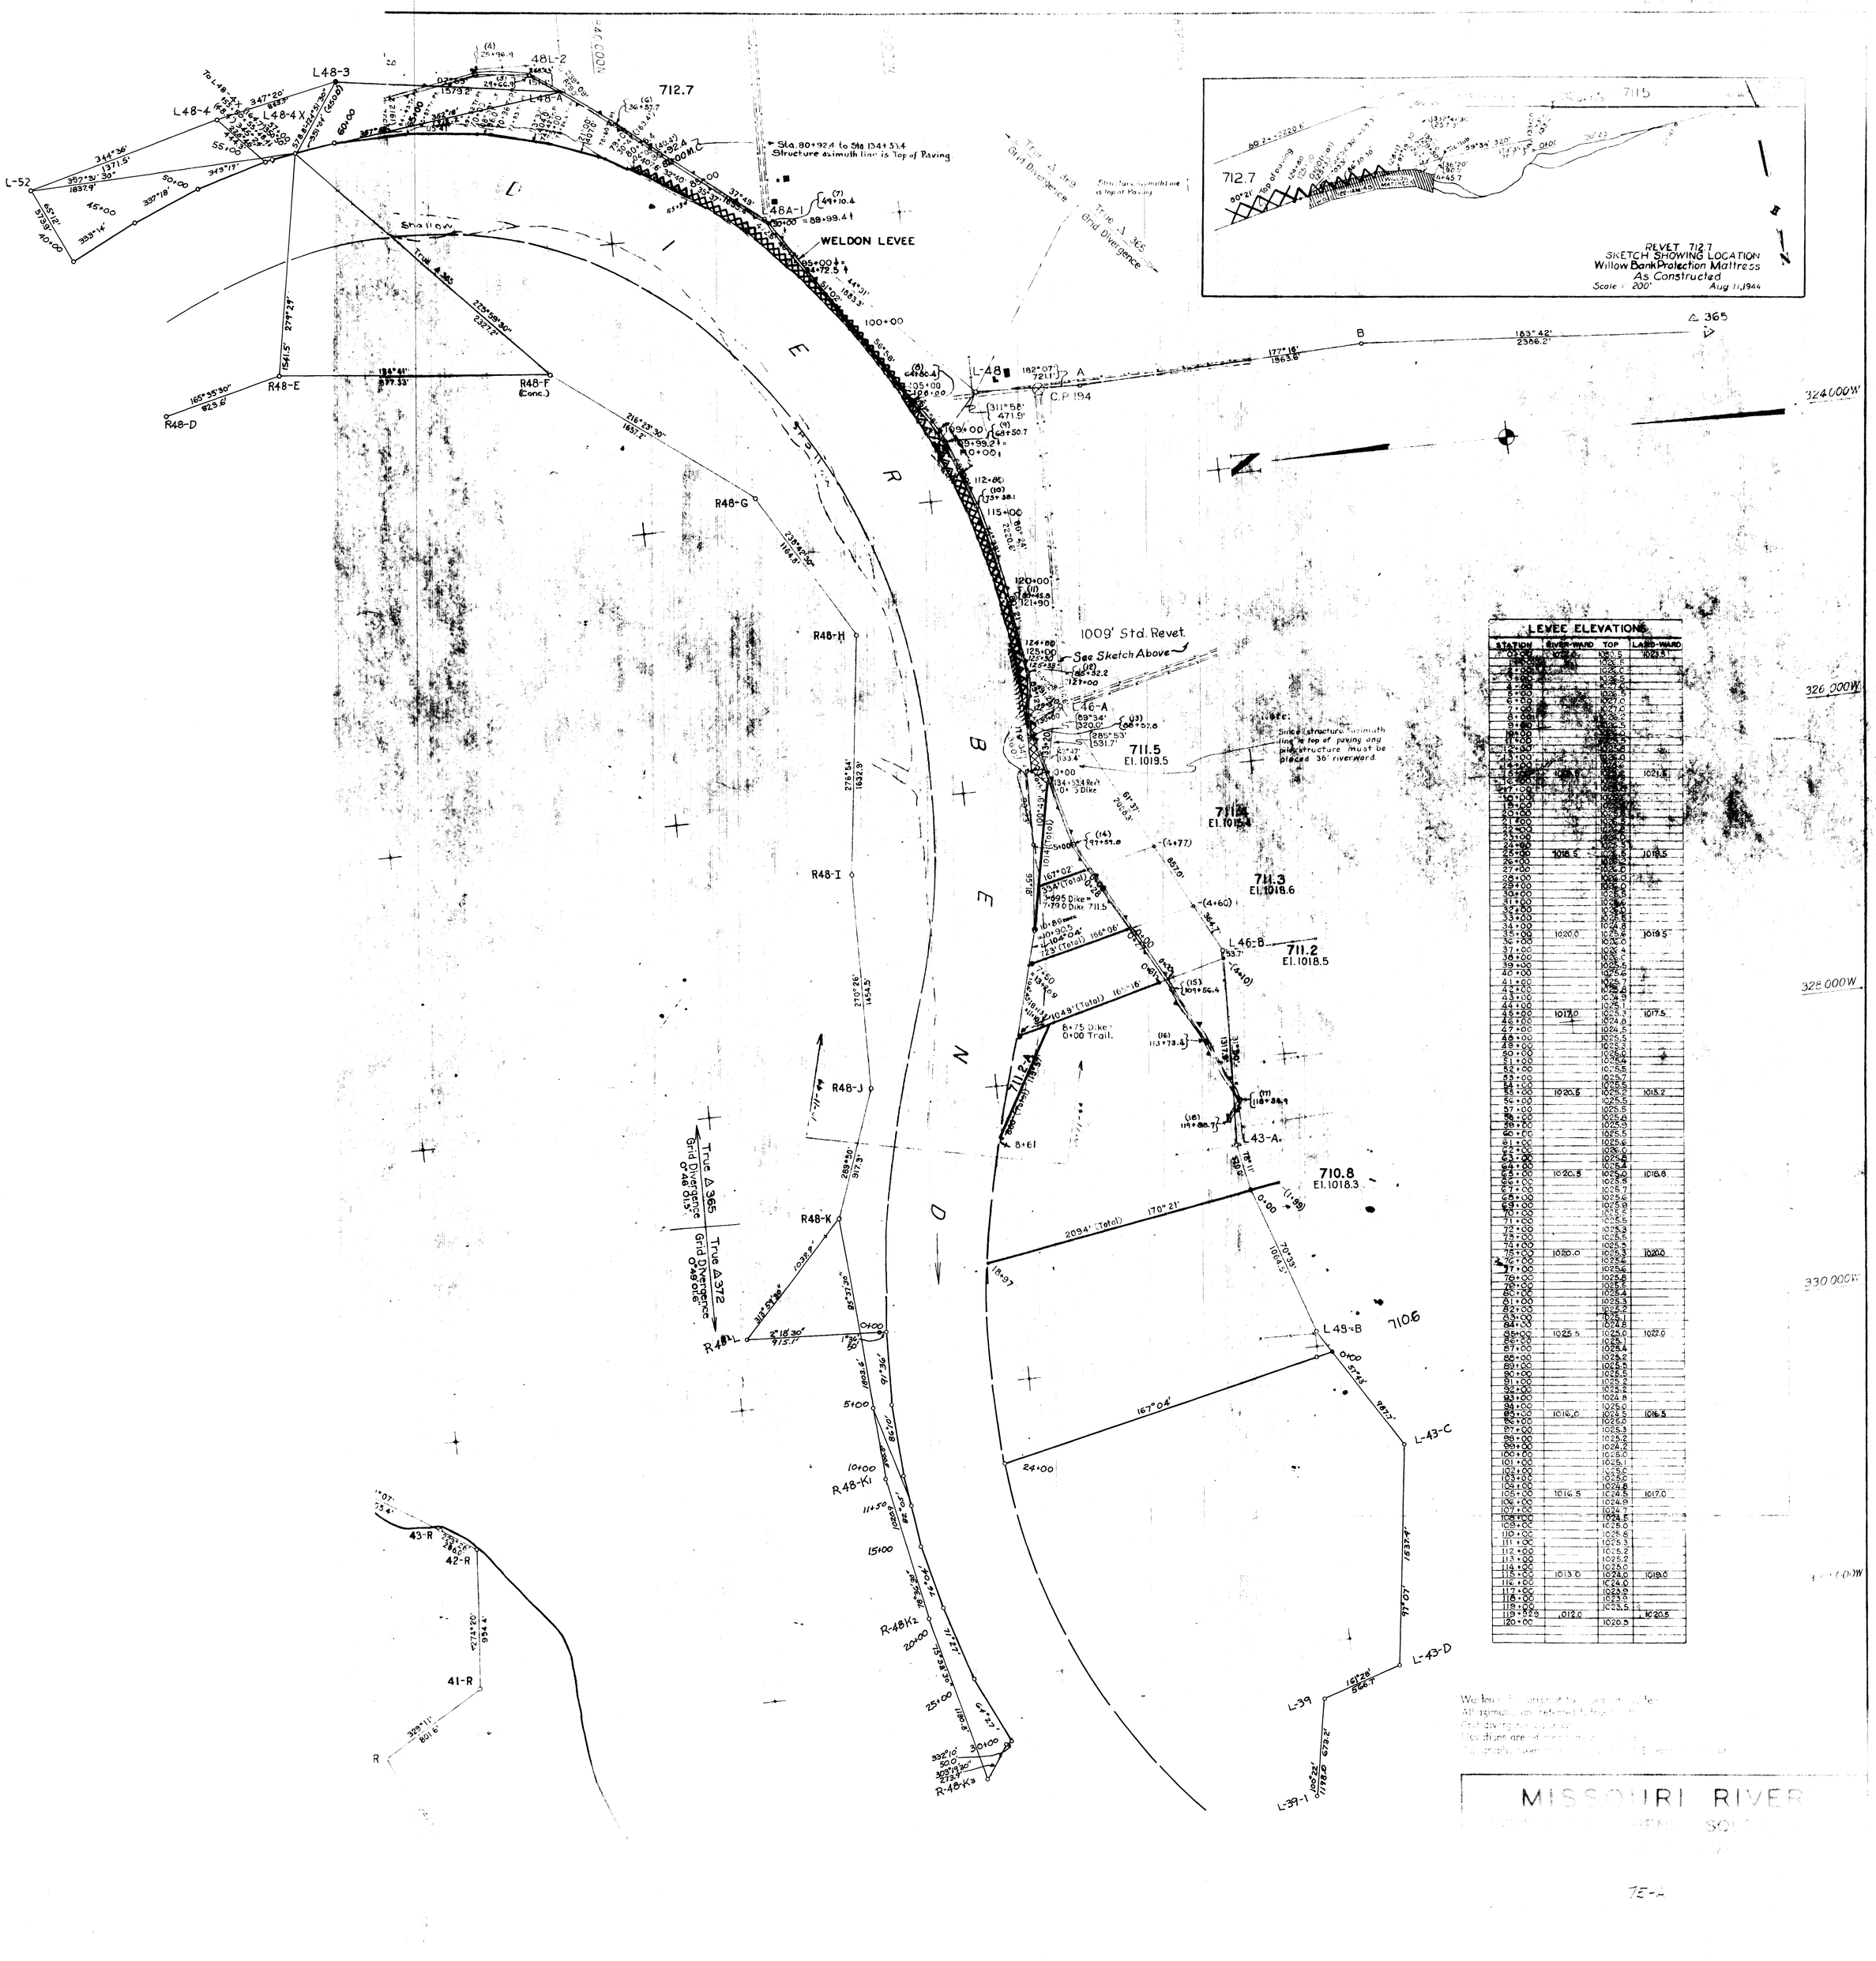

REVET 712.7
SKETCH SHOWING LOCATION
Willow Bank Protection Mattress
As Constructed
Scale 1" 200' Aug 11, 1944

LEVEE ELEVATIONS

STATION	RIVER-WARD	TOP	LAND-WARD
0+00	1022.0	1030.5	1023.5
1+00		1030.5	
2+00		1030.5	
3+00		1030.5	
4+00		1029.4	
5+00		1029.0	
6+00		1028.0	
7+00		1027.0	
8+00		1026.2	
9+00		1025.5	
10+00		1025.5	
11+00		1025.5	
12+00		1025.58	
13+00		1025.8	
14+00		1025.9	
15+00	1025.5	1026.0	1021.5
16+00		1026.0	
17+00		1026.0	
18+00		1026.0	
19+00		1026.0	
20+00		1026.0	
21+00		1025.9	
22+00		1025.8	
23+00		1025.7	
24+00		1025.6	
25+00	1018.5	1025.5	1018.5
26+00		1025.2	
27+00		1025.0	
28+00		1025.0	
29+00		1025.0	
30+00		1025.5	
31+00		1025.6	
32+00		1025.6	
33+00		1025.6	
34+00		1024.8	
35+00	1020.0	1025.6	1019.5
36+00		1026.0	
37+00		1026.4	
38+00		1026.5	
39+00		1025.5	
40+00		1025.6	
41+00		1025.7	
42+00		1025.6	
43+00		1024.9	
44+00		1025.1	
45+00	1017.0	1025.3	1017.5
46+00		1024.8	
47+00		1024.5	
48+00		1025.5	
49+00		1025.3	
50+00		1025.0	
51+00		1025.4	
52+00		1025.6	
53+00		1025.7	
54+00		1025.5	
55+00	1020.5	1025.2	1015.2
56+00		1025.5	
57+00		1025.5	
58+00		1025.8	
59+00		1025.5	
60+00		1025.5	
61+00		1025.6	
62+00		1026.0	
63+00		1025.8	
64+00		1025.4	
65+00	1020.5	1025.0	1016.8
66+00		1025.5	
67+00		1025.7	
68+00		1025.6	
69+00		1025.9	
70+00		1025.6	
71+00		1025.5	
72+00		1025.3	
73+00		1025.5	
74+00		1025.3	
75+00	1020.0	1025.3	1020.0
76+00		1025.6	
77+00		1025.6	
78+00		1025.8	
79+00		1025.5	
80+00		1025.4	
81+00		1025.3	
82+00		1025.2	
83+00		1025.1	
84+00		1024.8	
85+00	1025.5	1025.0	1022.0
86+00		1025.1	
87+00		1025.4	
88+00		1025.2	
89+00		1025.5	
90+00		1025.5	
91+00		1025.2	
92+00		1025.2	
93+00		1024.8	
94+00		1025.0	
95+00	1016.0	1024.5	1016.5
96+00		1025.0	
97+00		1025.3	
98+00		1025.2	
99+00		1024.2	
100+00		1025.0	
101+00		1025.1	
102+00		1025.0	
103+00		1025.0	
104+00		1024.8	
105+00	1016.5	1024.5	1017.0
106+00		1024.9	
107+00		1024.7	
108+00		1024.5	
109+00		1025.0	
110+00		1025.6	
111+00		1025.3	
112+00		1025.2	
113+00		1025.2	
114+00		1025.0	
115+00	1013.0	1024.0	1019.0
116+00		1024.0	
117+00		1023.9	
118+00		1023.9	
119+00		1023.5	
119+32.9	1012.0		1020.5
120+00		1020.5	

We found [illegible]
All azimuths are referred to [illegible]
Grid Divergence [illegible]
Elevations are referred to [illegible]
[illegible]

MISSOURI RIVER
[illegible] SOU[illegible]

7E-2