UNION PACIFIC RAILROAD

NEBRASKA DIVISION — MAIN LINE

Council Bluffs to Gilmore Junction

VIA OLD MAIN LINE, SUMMIT TO LANE

POTTAWATTAMIE COUNTY, IOWA AND
DOUGLAS AND SARPY COUNTIES, NEBRASKA

M. P. 0 TO M. P. 11.8

Station 0+93 to Station 631+00

Section 36, T. 75 N., R. 44 W. to Section 33, T. 75 N., 44 W. West of 5th Principal Meridian, and Section 22, T. 15 N., R. 13 E. to Section 34, T. 14 N., R. 13 E. 6th Principal Meridian.

Scale 1" = 400'

Chief Engineer's Office, U.P.R.R. Co., Omaha, Nebr., March 12, 1953

Platted from Maps, C. E. Drawings No. 37458, No. 53755, No. 54152, No. 54337, No. 54587, No. 80254, and No. 80220, also "As Constructed" Work Order Prints to date, C.B.&Q.R.R. Map C. E. Drawing No. 54399 and M.P.R.R. Map C. E. Drawing No. 54397.

PLATTED BY	TRACED BY	CHECKED BY
I.M.S.	I.M.S.	S. T. B.

CHECKED AS TO RIGHT OF WAY BY _____ DATE _____

C. E. DRAWING NO. 80641

Corrected to

LEGEND — TRACKS

- U.P.R.R.
- C.B.&Q.R.R.
- C.&W.R.Y.
- C.B.&Q.R.R.
- C.N.W.R.Y.
- Mo.Pac.R.R.
- S.O. Term. Ry.
- Ill. Cent. R.R.
- Wabash R.R.
- C.M.St.P.&P.R.R.
- Priv. Owned

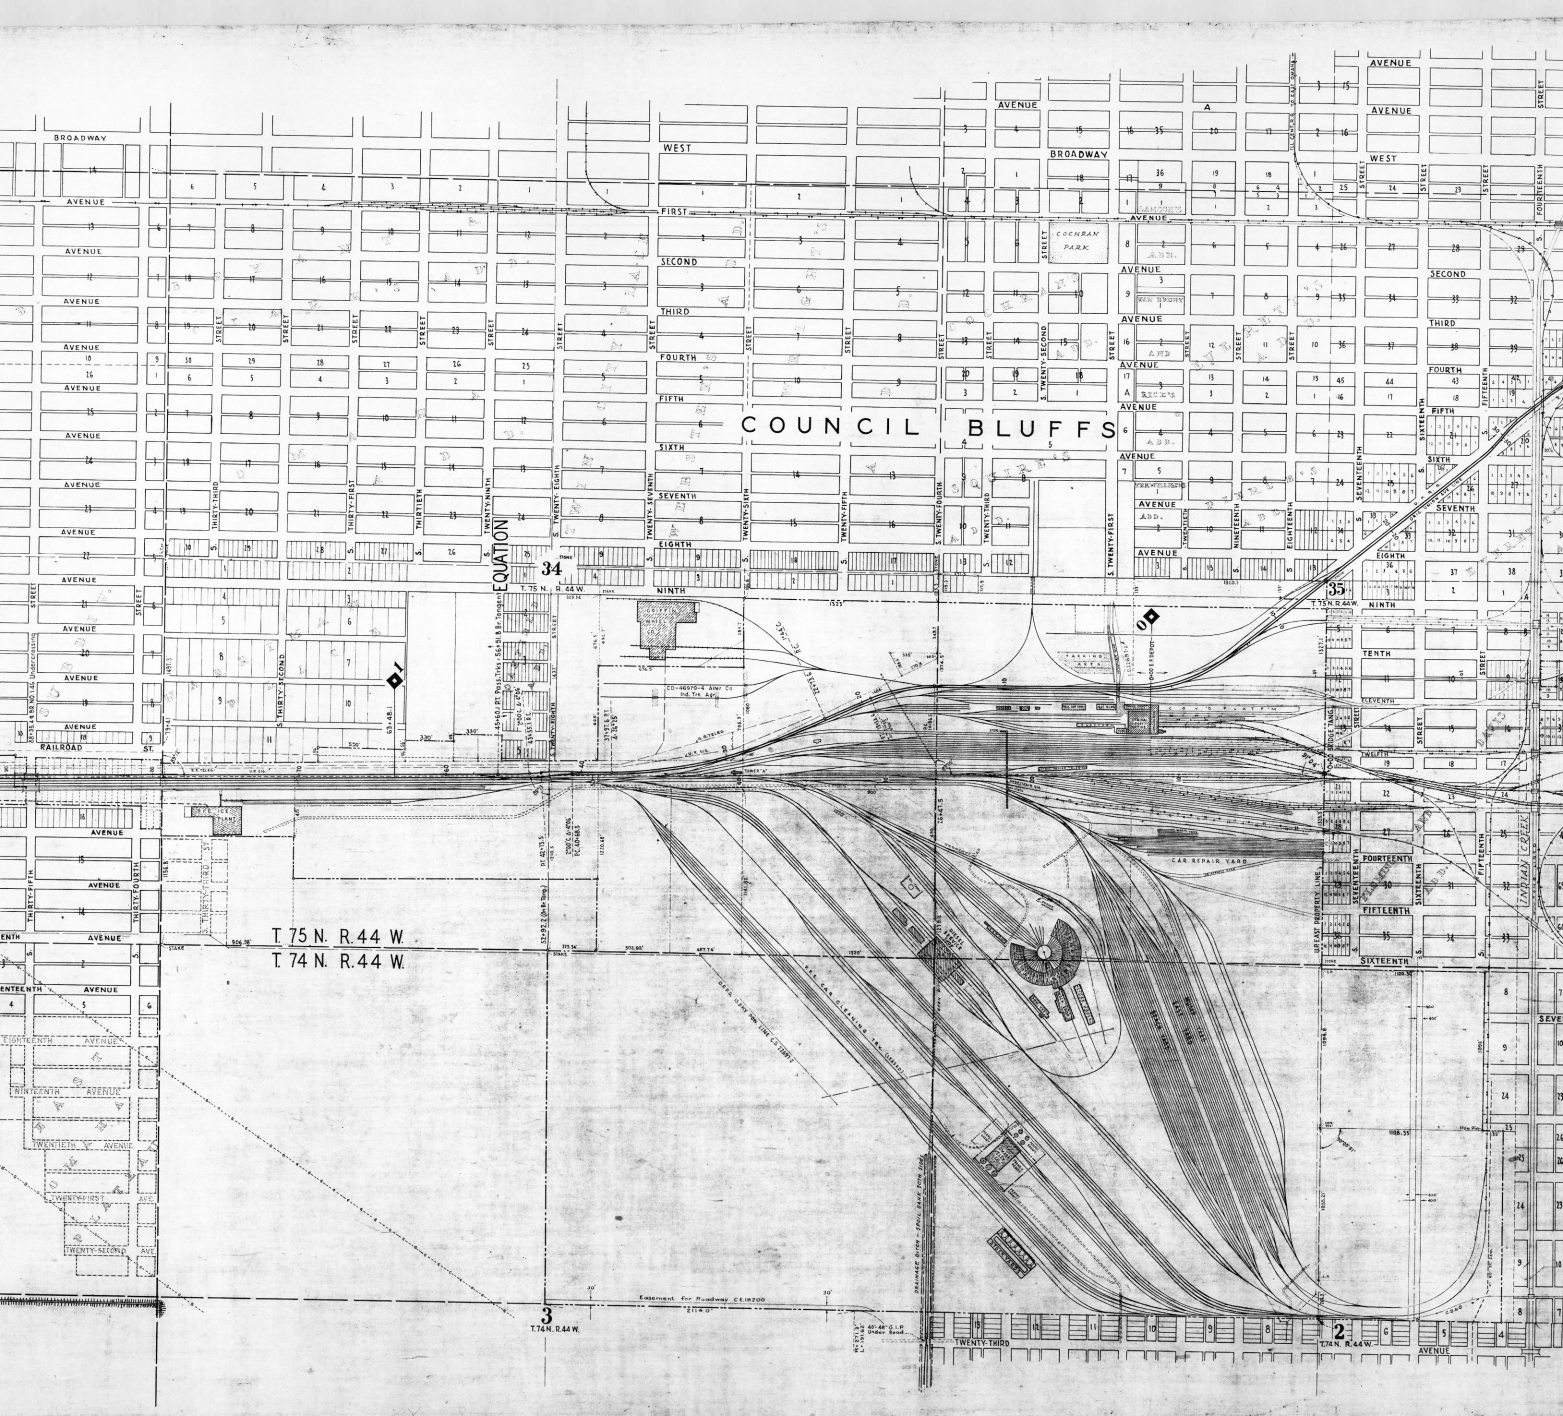
COUNCIL BLUFFS
EQUATION
T. 75 N. R. 44 W.
T. 74 N. R. 44 W.
RAILROAD
ST.
BROADWAY
WEST
FIRST
SECOND
THIRD
FOURTH
FIFTH
SIXTH
SEVENTH
EIGHTH
NINTH
TENTH
ELEVENTH
TWELFTH
FOURTEENTH
FIFTEENTH
SIXTEENTH
SEVENTEENTH
TWENTY-THIRD
COCHRAN PARK
CAR REPAIR YARD
INDIAN CREEK
Easement for Roadway
DRAINAGE DITCH - SPOIL BANK BOTH SIDES
34
35
3
2

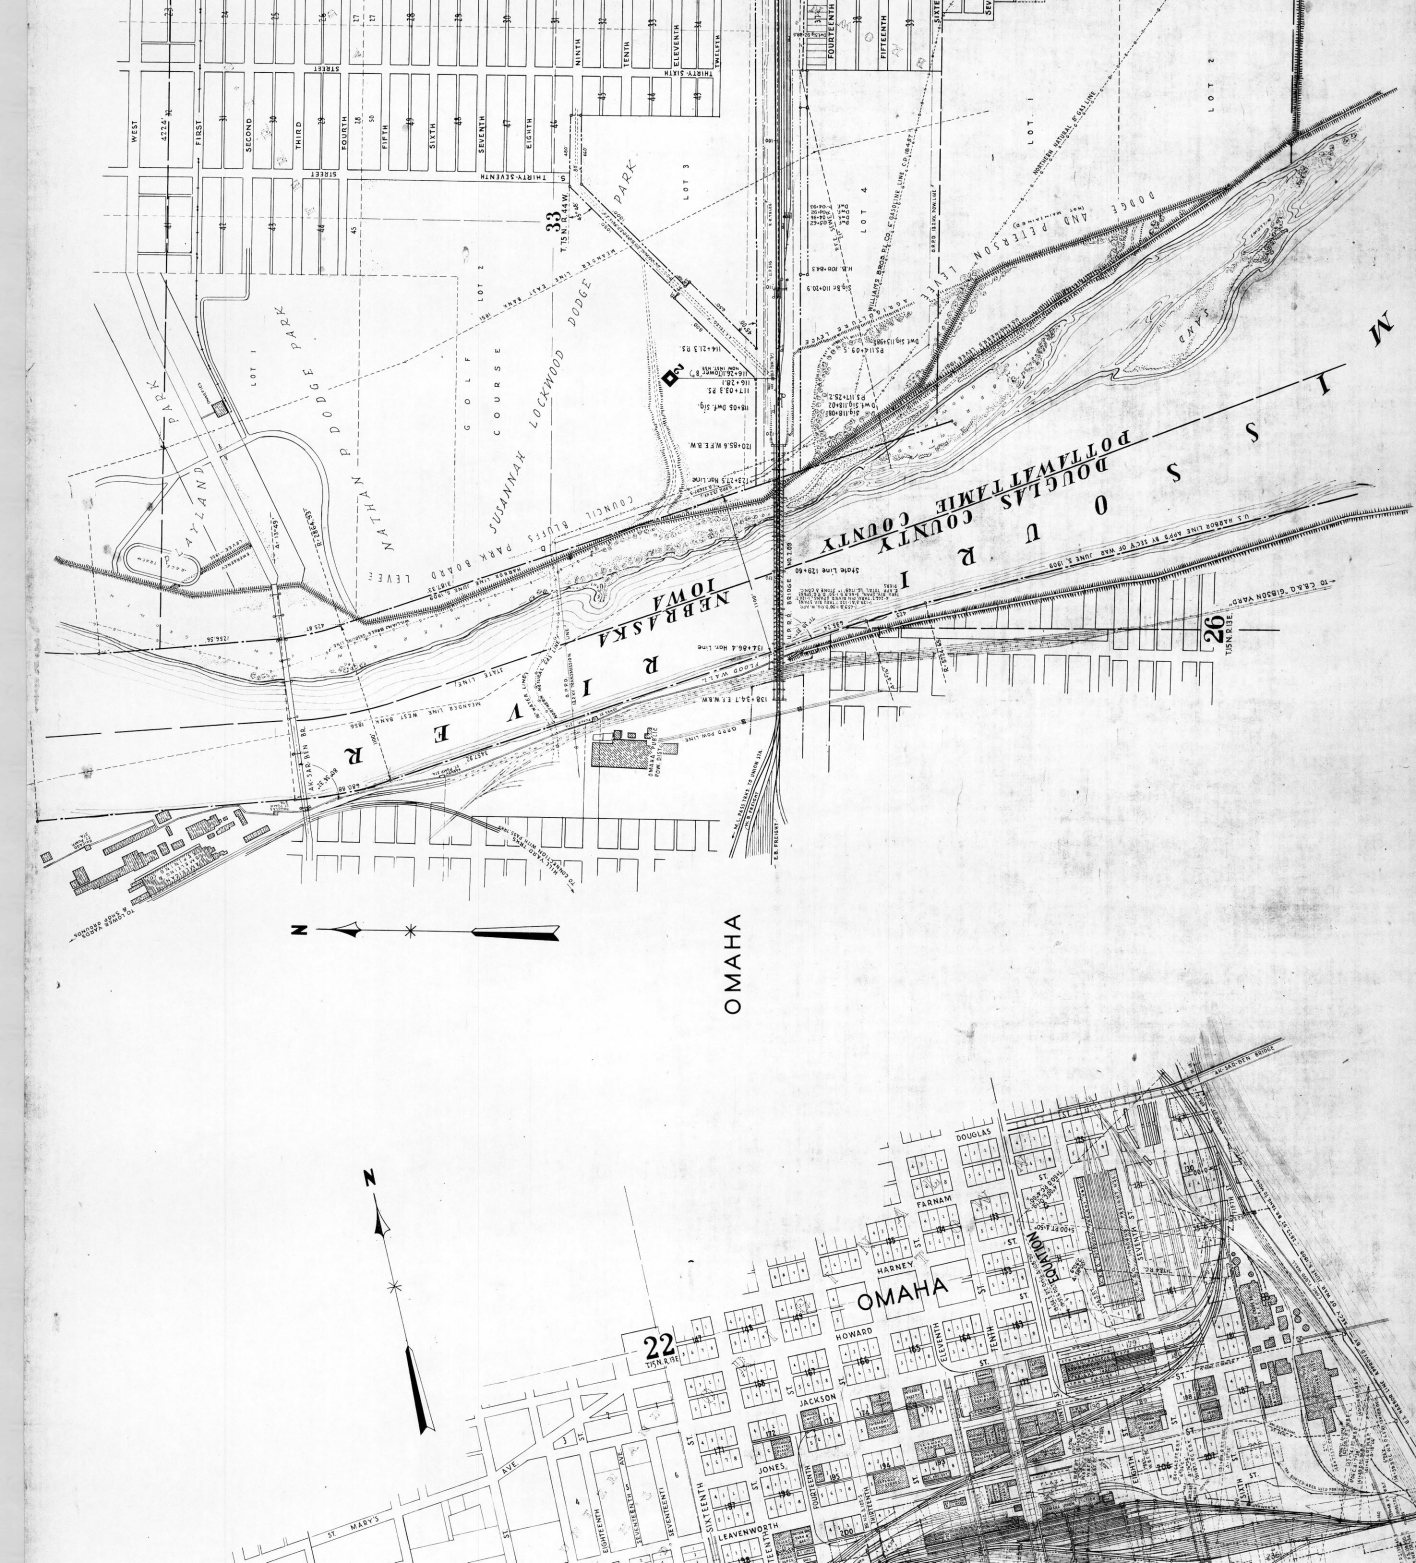
MISSOURI RIVER
NEBRASKA
IOWA
DOUGLAS COUNTY
POTTAWATTAMIE COUNTY
NATHAN P DODGE PARK
LOCKWOOD DODGE PARK
SUSANNAH GOLF COURSE
COUNCIL BLUFFS PARK BOARD LEVEE
OMAHA
DOUGLAS
FARNAM
HARNEY
HOWARD
JACKSON
JONES
LEAVENWORTH
ST MARY'S
CAMDEN
EARLY
WEST
FIRST
SECOND
THIRD
FOURTH
FIFTH
SIXTH
SEVENTH
EIGHTH
NINTH
TENTH
ELEVENTH
TWELFTH
THIRTY-SEVENTH
FOURTEENTH
FIFTEENTH
SIXTEENTH
SEVENTEENTH
33
T15N R13E
26
T15N R12E
22
T15N R13E
N

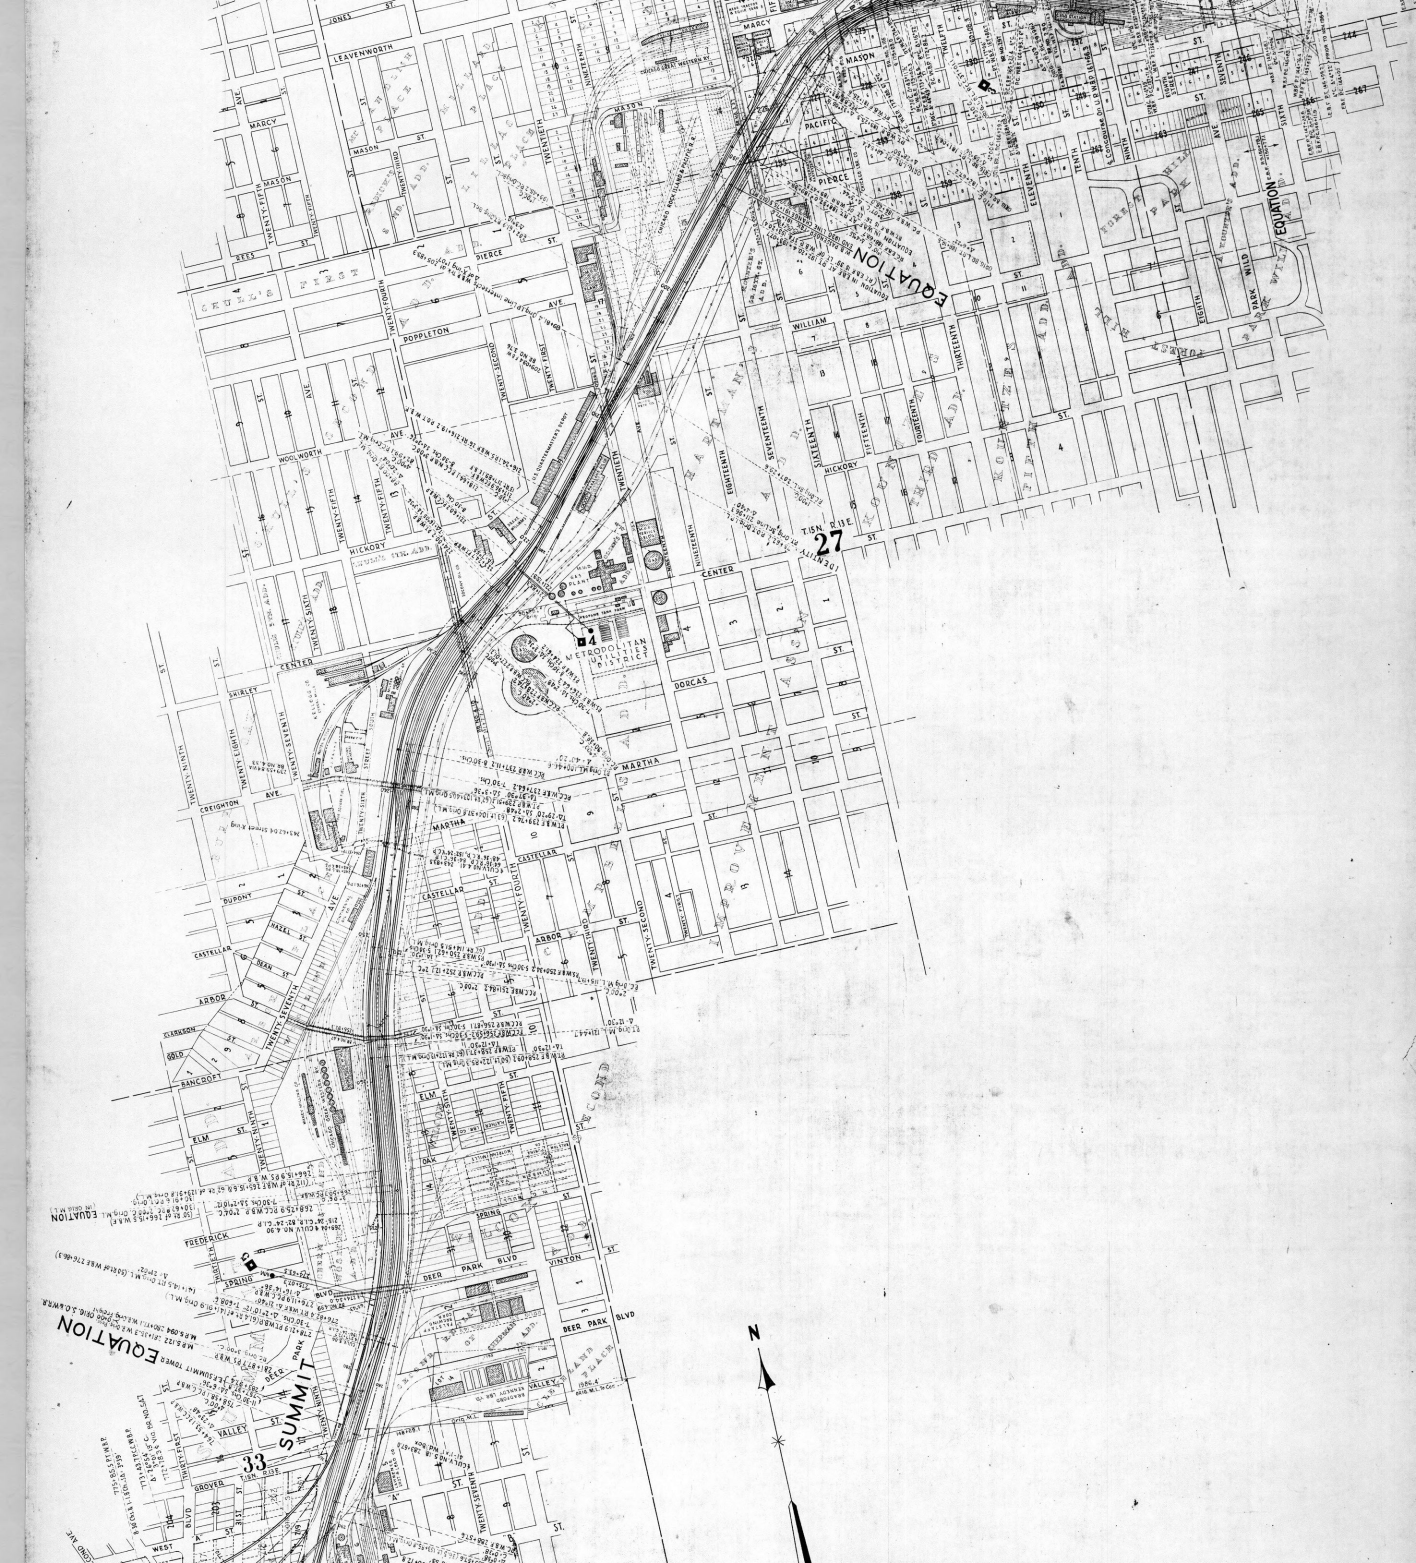
JONES ST
LEAVENWORTH ST
MARCY ST
MASON ST
PACIFIC AVE
PIERCE ST
POPPLETON AVE
HICKORY ST
WILLIAM ST
CENTER ST
DOUGLAS ST
MARTHA ST
CASTELLAR ST
ARBOR ST
ELM ST
DEER PARK BLVD
JINTON ST
SPRING ST
FREDERICK ST
VALLEY ST
GROVER ST
WEDT ST
T15N R1E
27
T15N R1E
33
EQUATION
SUMMIT
METROPOLITAN WATER DISTRICT
N

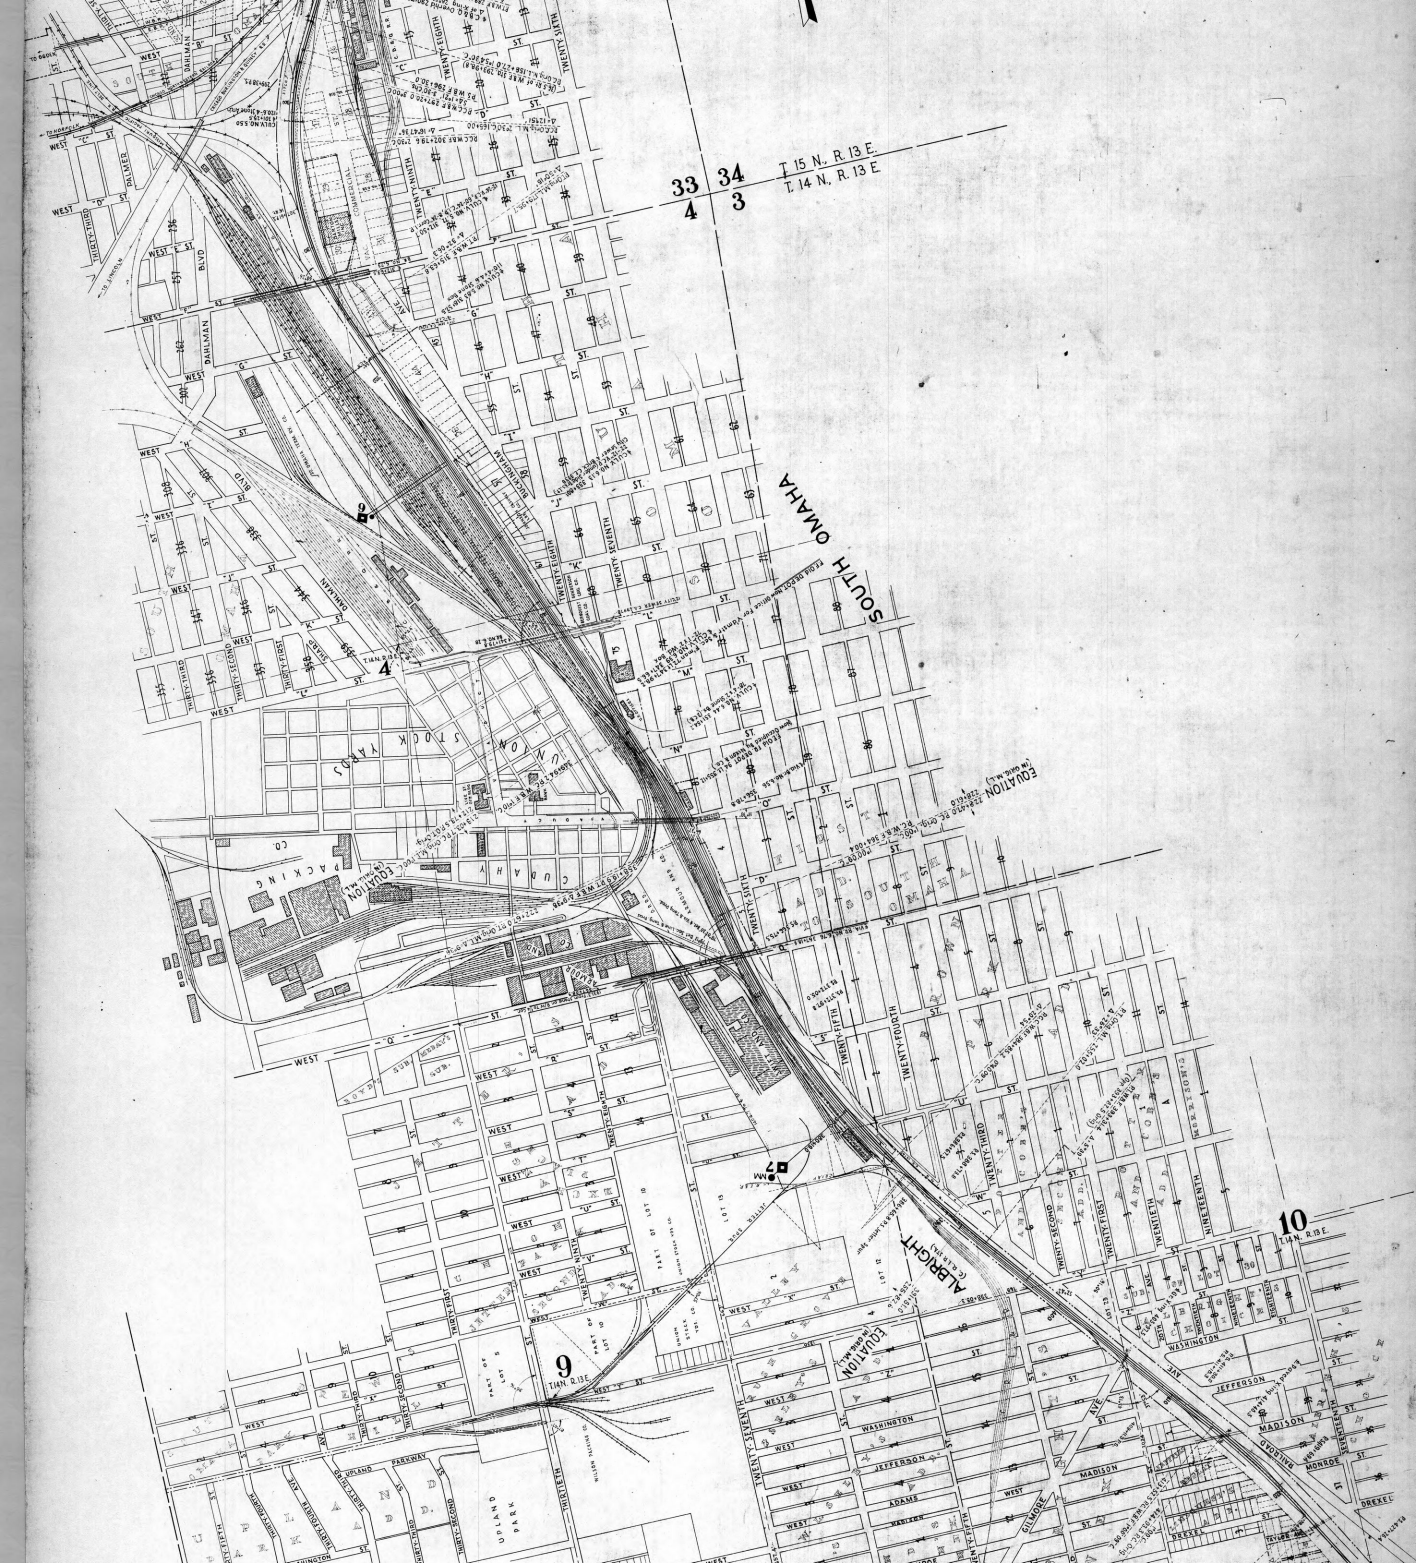
33
4
34
3
T. 15 N., R. 13 E.
T. 14 N., R. 13 E.
SOUTH OMAHA
UNION STOCK YARDS
CUDAHY
PACKING
CO.
9
T.14N. R.13E.
10
T.14N. R.13E.
ABRIGHT
UPLAND PARK
TWENTY-FOURTH
TWENTY-FIFTH
TWENTY-SIXTH
TWENTY-SEVENTH
TWENTY-EIGHTH
TWENTY-NINTH
THIRTIETH
THIRTY-FIRST
WEST
WASHINGTON
JEFFERSON
MADISON
MONROE
DREXEL
ADAMS
MARION
GILMORE
PARKWAY
DAHLMAN
BLVD

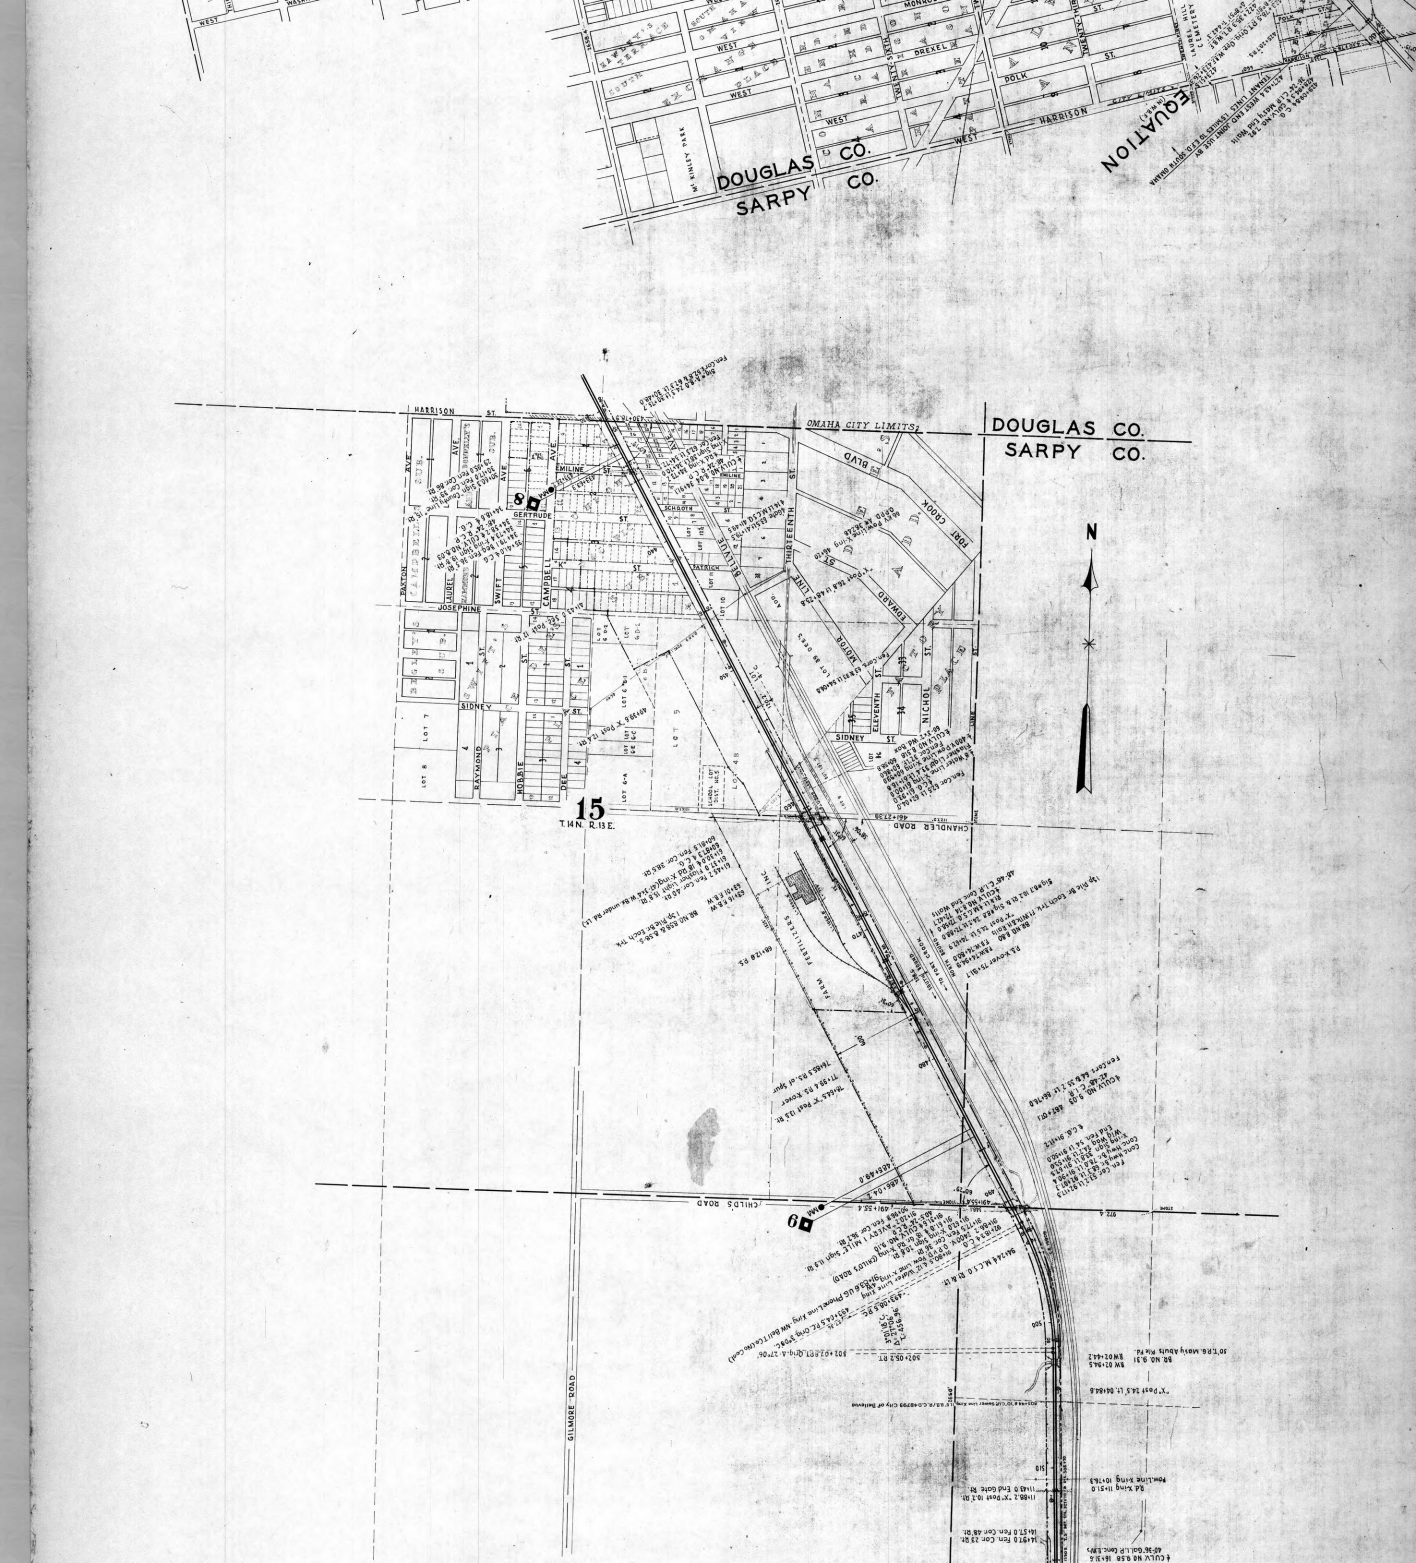
DOUGLAS CO.
SARPY CO.
OMAHA CITY LIMITS
HARRISON ST
DREXEL ST
DOLK ST
WEST
EQUATION
DOUGLAS CO.
SARPY CO.
N
15
T.14N. R.13E.
CHANDLER ROAD
CHILD'S ROAD
GILMORE ROAD
HIGH FIFTEENTH ST
SIDNEY ST
JOSEPHINE
GERTRUDE
EMILINE
SWIFT
CANDELL
KEYSTONE
ROBBIE
DEE
PATTON
AVE
BLVD
FORT CROOK
EDWARD
NICHOLAS
ELEVENTH
PATRICK
SCHOOL
LOT 5
LOT 6
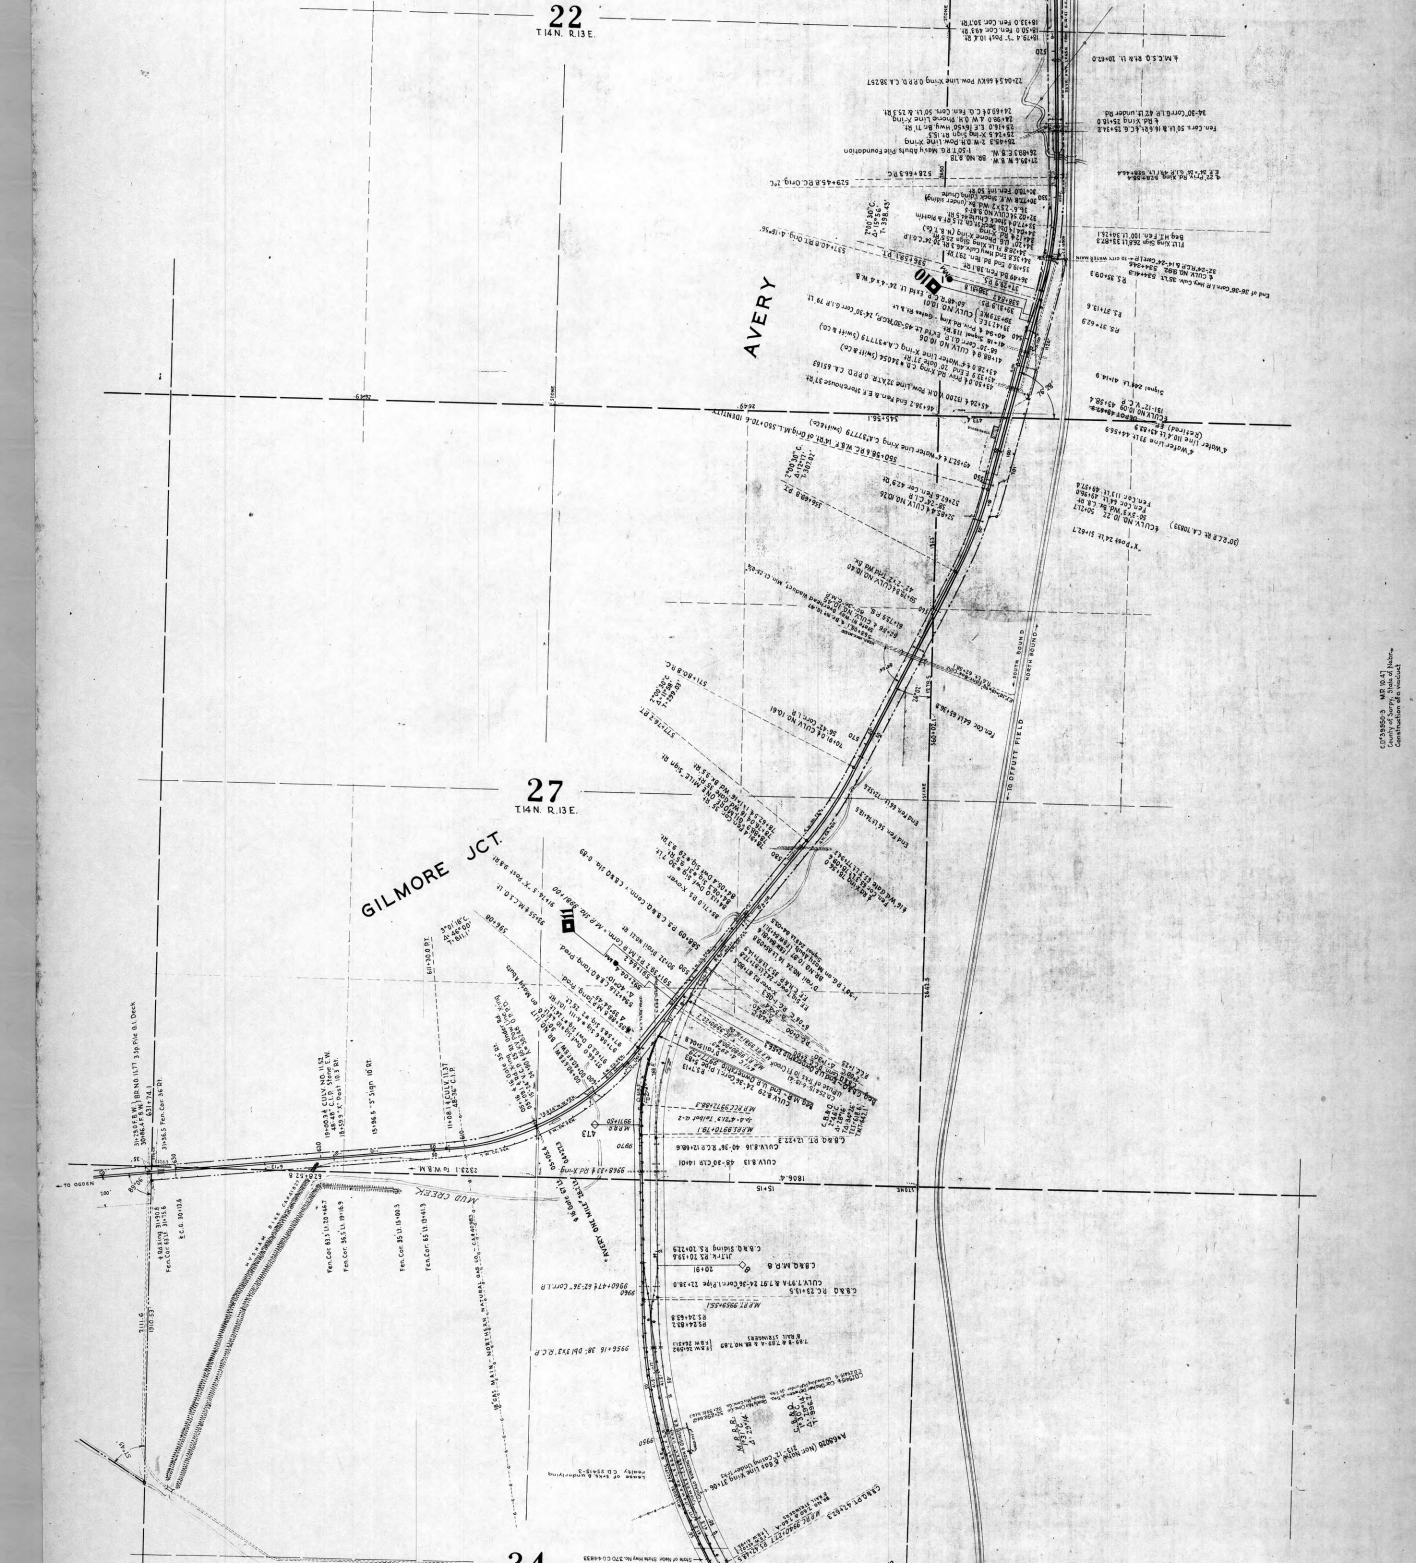
22
T.14N. R.13E.
AVERY
27
T.14N. R.13E.
GILMORE JCT.
TO OFFUTT FIELD
MUD CREEK
24

UNION PACIFIC RAILROAD

NEBRASKA DIVISION — MAIN LINE

Council Bluffs to Gilmore Junction

VIA OLD MAIN LINE, SUMMIT TO LANE

POTTAWATTAMIE COUNTY, IOWA AND
DOUGLAS AND SARPY COUNTIES, NEBRASKA

M. P. 0 TO M. P. 11.8

Station 0 - 0 to Station 591 - 00

Section 36, T. 75 N., R. 44 W. to Section 23, T. 75 N. 44 W. West of 5th Principal Meridian, and Section 22, T. 15 N., R. 13 E. to Section 34, T. 14 N., R. 13 E. 6th Principal Meridian.

Scale 1" = 400'

Chief Engineer's Office, U.P.R.R. Co., Omaha, Nebr., March 12, 1953

Plotted from Maps, C. E. Drawings No. 37458, No. 53755, No. 54152, No. 54397, No. 54587, No. 80224, and No. 80320, also "As Constructed" Work Order Prints to date. C.B.&Q.R.R. Map C. E. Drawing No. 54399 and M.P.R.R. Map C. E. Drawing No. 54397.

PLOTTED BY	TRACED BY	CHECKED BY
I. M. S.	I. M. S.	B. F. B.

CHECKED AS TO RIGHT OF WAY BY _____ DATE _____

C. E. DRAWING NO. 80641

Corrected to

LEGEND — TRACKS
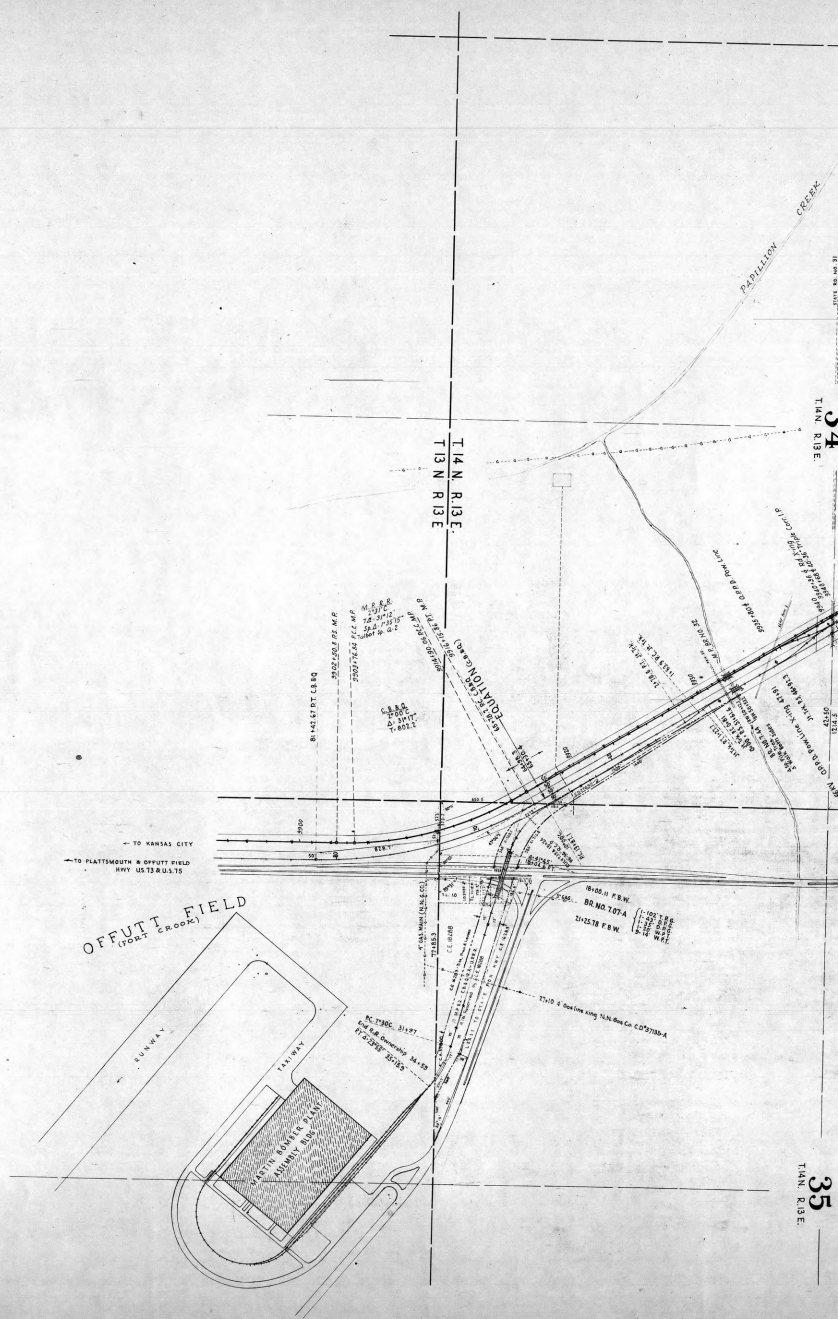
U.P.R.R.	S.O. Term. Ry.
C.R.I.&P.R.R.	Ill. Cent. R.R.
C.G.W.RY.	Wabash R.R.
C.B.&Q.R.R.	C.M.St.P.&P.R.R.
C.N.W.RY.	Pub. Owned