UNION PACIFIC RAILROAD

NEBRASKA DIVISION

LANE TO BEYOND AMES

DOUGLAS & DODGE COUNTIES NEBRASKA

M.P. 117.0 to M.P. 131.00

Stations 0+00 to Station 1396+00

Sections 32, T 15 N, R 11 E, Sections 1, 11, 12 T 14 N, R 11 E.

Section 6 T 14 N, R 10 E.

Office of Chief Engineer, U.P.R.R. Omaha, Nebr., July, 1917


LANE
EQUATION
22
21
19
18
15N | R1E

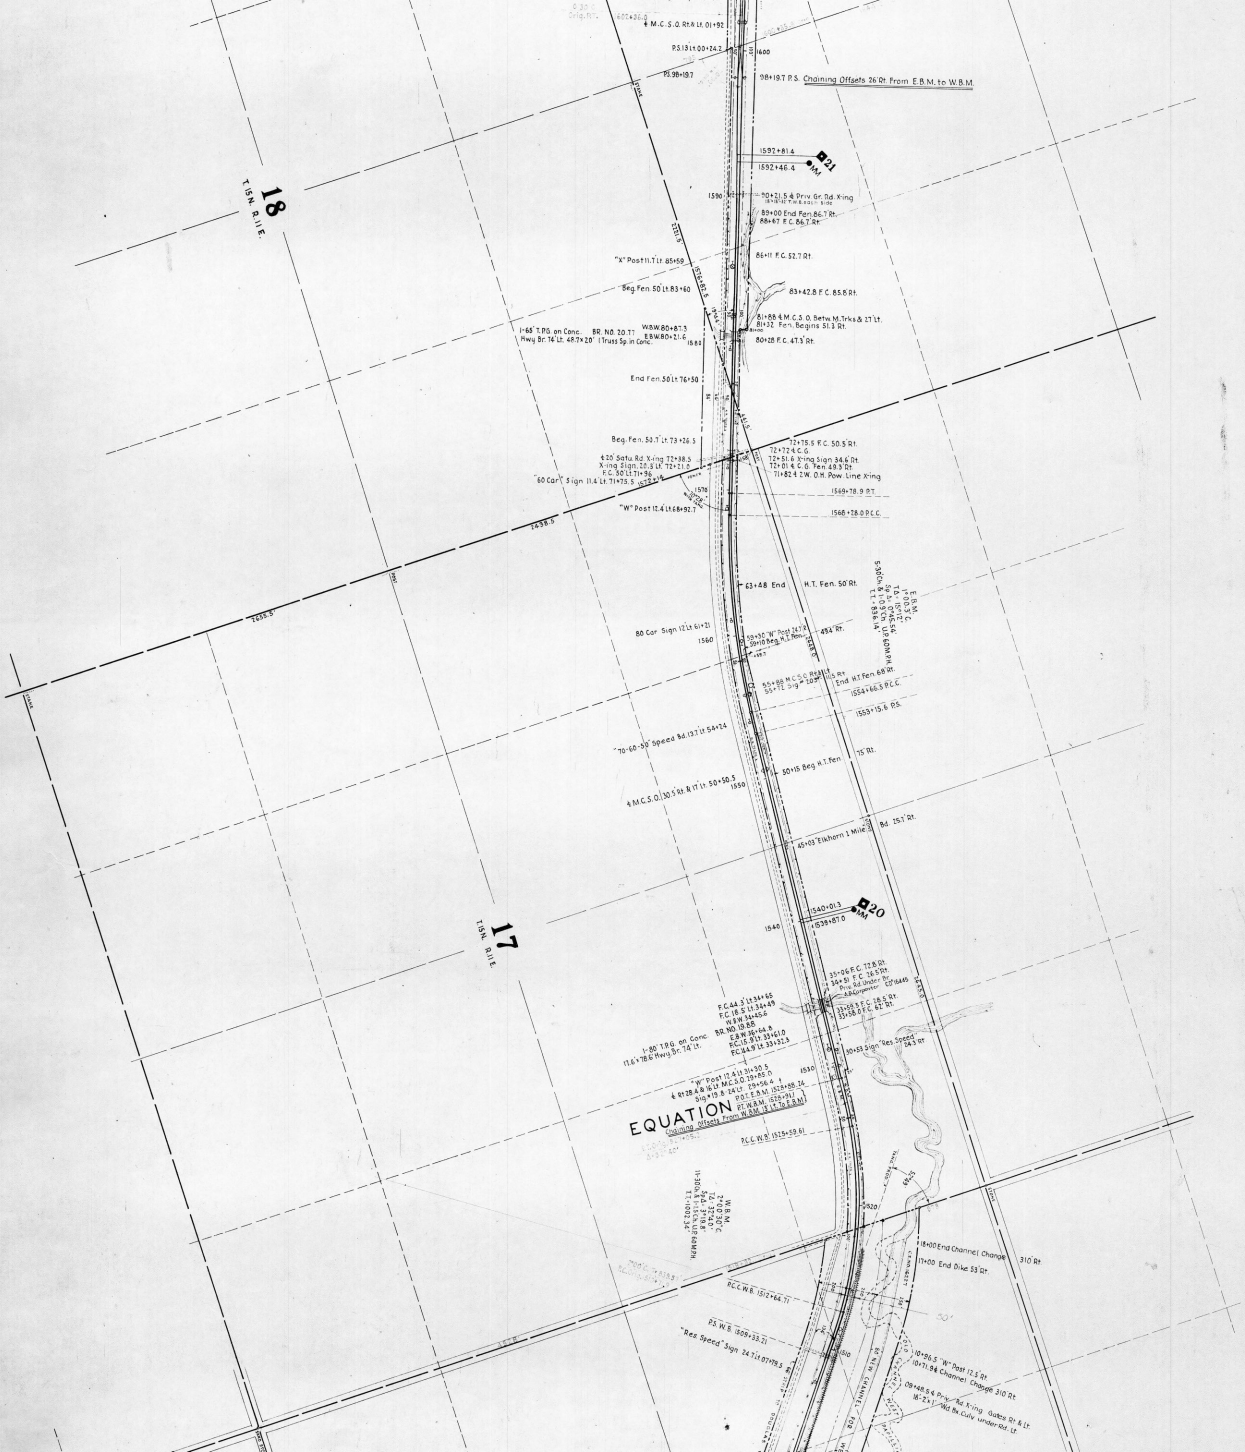
T.15N. R.11E.
18
T.15N. R.11E.
17
EQUATION
Following Offsets from M.B.M. 18 (N.E.B.M.)
P.S. 98+19.7
98+19.7 P.S. Chaining Offsets 26' Rt. From E.B.M. to W.B.M.
1592+81.4
1592+46.4
B.M. 21
90+21.5 & Privy Gr. Rd. Xing
89+00 End Fen. 86.7 Rt.
88+67 F.C. 86.7 Rt.
86+11 F.C. 52.7 Rt.
"X" Post 11.7 Lt. 85+58
Beg. Fen. 50 Lt. 83+60
83+42.8 F.C. 85.8 Rt.
81+88.4 M.C.S.O. Betw. M. Trks. & 17' Lt.
81+32 Fen. Begins 51.3 Rt.
80+28 F.C. 47.3 Rt.
W.B.M. 80+87.3
E.B.M. 80+21.6
1-66' T.P.G. on Conc. Hwy Br. 74' Lt. 48.7 x 20' I Truss Sp. in Conc.
BR. NO. 20.77
End Fen. 50 Lt. 76+50
Beg. Fen. 50.7' Lt. 73+26.3
72+75.5 F.C. 50.5 Rt.
72+72.4 C.G.
72+51.6 Xing Sign 34.6 Rt.
72+01.4 C.G. Pen 49.3 Rt.
71+82.4 I.W. O.H. Pow. Line Xing
1576
1575
"W" Post 11.4 Lt. 71+75.5
"60 Car" Sign 11.4 Lt. 71+75.5
Rt. 72+76.6
Rt. 72+72.4
Rt. 72+51.6
Rt. 72+01.4
Rt. 71+82.4
"W" Post 11.4 Lt. 68+92.7
1568+78.0 P.C.C.
1569+78.9 P.T.
2638.9
2638.9
63+48 End
H.T. Fen. 50 Rt.
80 Car Sign 12 Lt. 61+21
59+30 "W" Post 24.7 Lt. Bend Beg. R.R. Fence
494' Rt.
End H.T. Fen. 68 Rt.
55+66.5 P.C.C.
55+15.8 P.T.
"70-60-50" Speed Sg. 24.7 Lt. 54+74
50+18 Beg. H.T. Fen.
75' Rt.
8 M.C.S.O. 50.5 Rt. & 17' Lt. 50+50.5
45+03 Eikhorn 1 Mile Sg.
Rd. 25.7 Rt.
B.M. 20
1540+01.3
1539+87.0
F.C. 44.3' Lt. 34+65
F.C. 18.5' Lt. 34+49
W.B.M. 34+45.6
BR. NO. 10.88
E.B.M. 30+44.8
P.C. 15.9' Lt. 33+61.0
P.C. 44.9' Lt. 33+32.3
35+06 F.C. 72.8 Rt.
34+51 F.C. 76.5 Rt.
Prim. Rd. Under Br. Conf. 0449
Abandonment
33+63.5 F.C. 18.5 Rt.
33+58.0 F.C. 62.7 Rt.
1-80' T.P.G. on Conc. 17.6 x 78.6 Hwy Br. 74' Lt.
30+53 Sign "Res. Speed" 24.3 Rt.
"W" Post 12.4 Lt. 31+30.5
4 @ 28.6 & 8 @ 0' M.C.S.O. 29+85.0
Sig. 19.8 Lt. 24.2' 29+56.4
P.O.T. E.B.M. 1525+89.2
W.B.M. 1525+89.34
P.C.C. W.B. 1515+59.61
P.S. W.B. 1509+33.2
"Res. Speed" Sign 24.7 Lt. 07+79.5
1510+66.71
1511+00 End Channel Change
1517+00 End Dike 53 Rt.
310' Rt.
1510+56.5 W" Post 17.6 Rt.
1071.94 Channel Change 310 Rt.
09+46.6 Prim. Rd. Xing. Gates Rt. & Lt.
18' x 1' Mid. Rk. Curb. under dist. Lt.
N

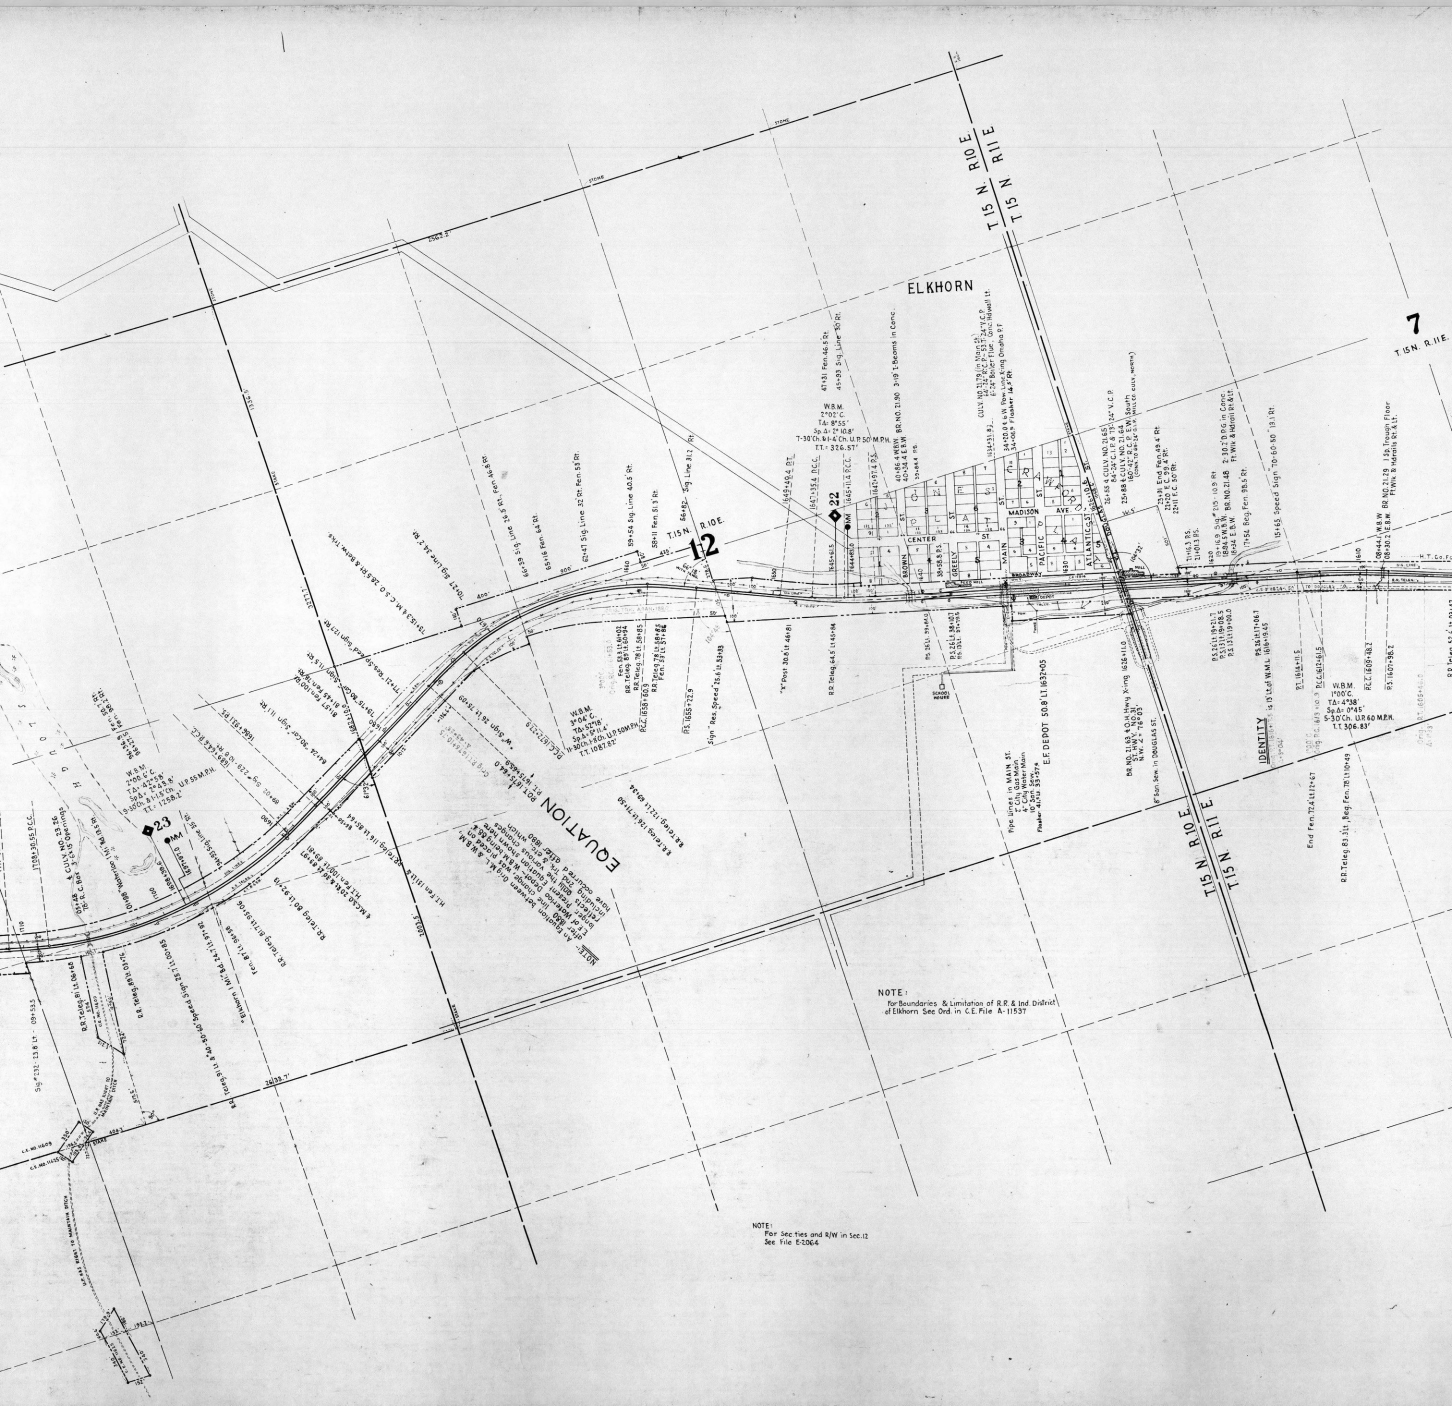
ELKHORN
T 15 N R 10 E
T 15 N R 11 E
T 15 N R 10 E
T 15 N R 11 E
7
T 15 N R 11 E
12
22
23
MADISON AVE
CENTER ST
MAIN ST
PACIFIC AVE
ATLANTIC AVE
BROADWAY
EQUATION
NOTE:
For Boundaries & Limitation of R.R. & Ind. District of Elkhorn See Ord. in C.E. File A-11537
NOTE:
For Sec ties and R/W in Sec. 12 See File E-206.4

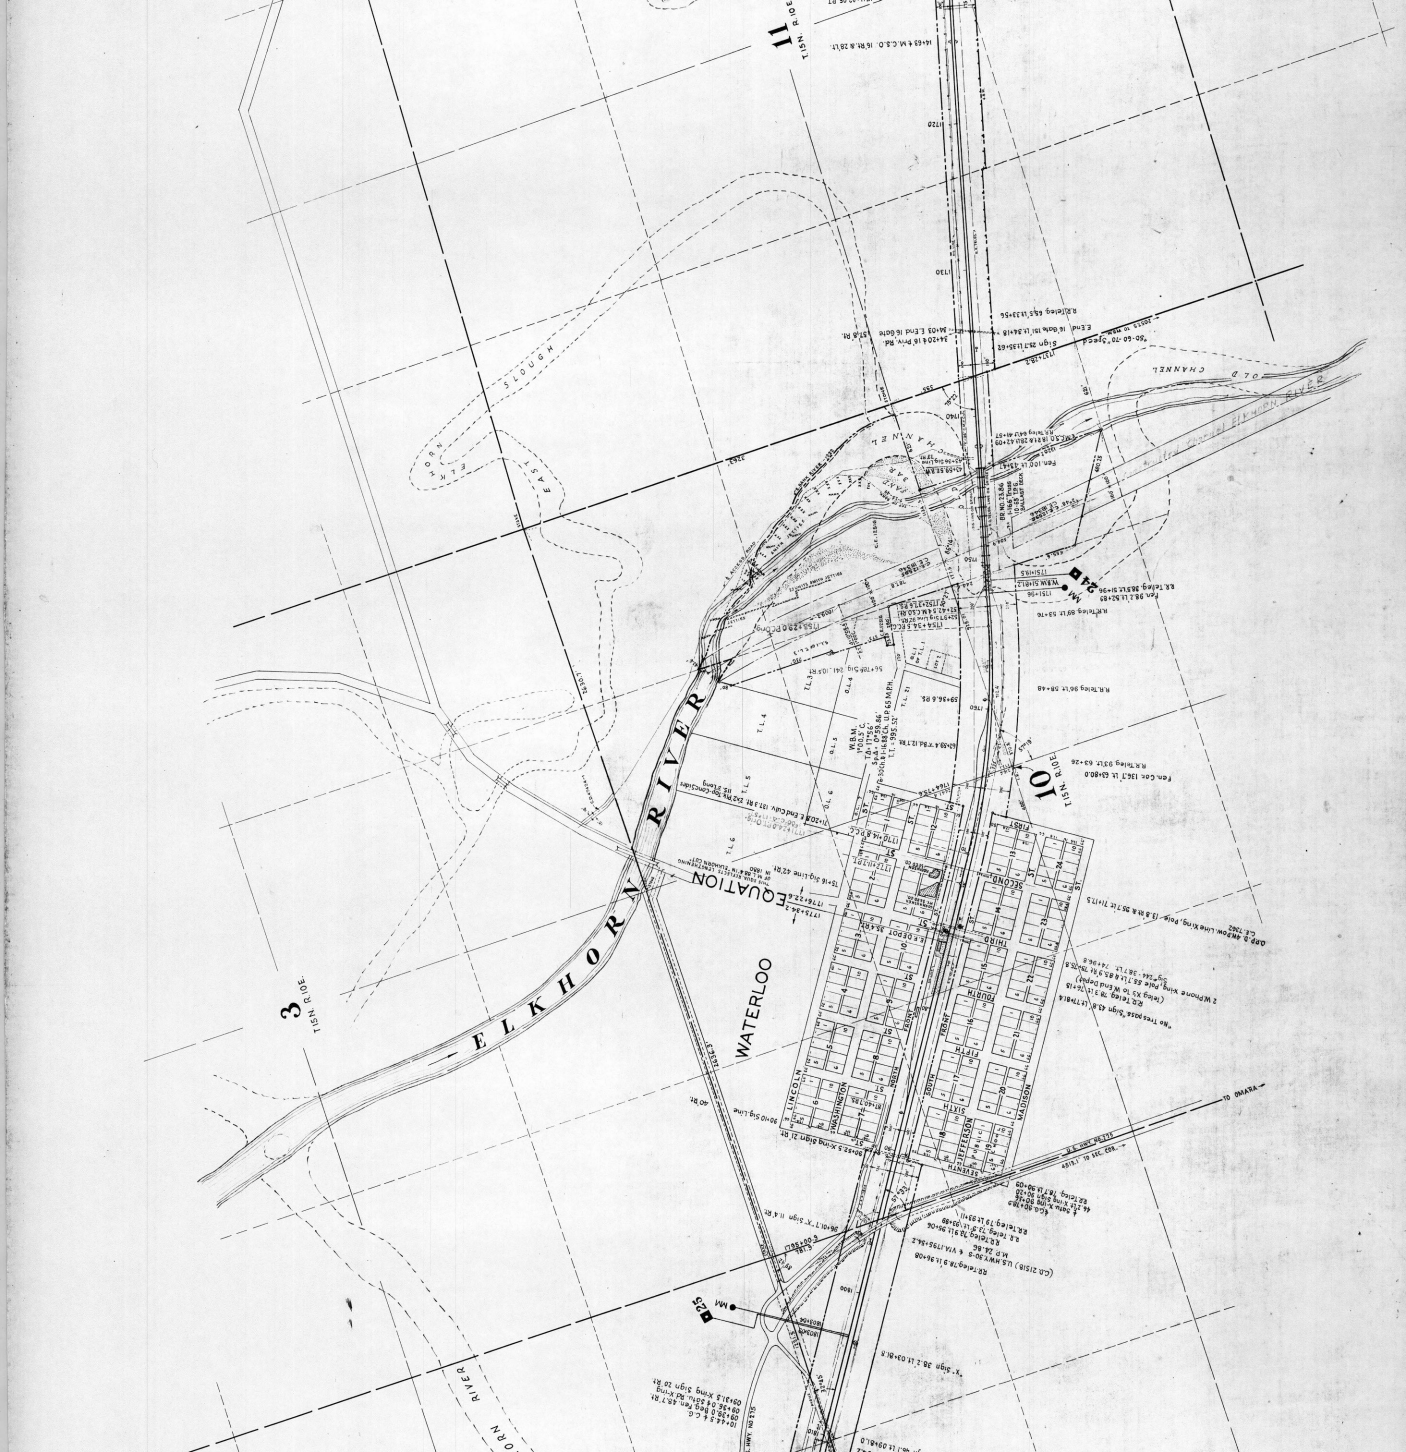
ELKHORN RIVER
WATERLOO
EQUATION
OLD CHANNEL
CHANNEL
MARSH
SLOUGH
EAST
T15N R10E
T15N R9E
3
11
10
FIRST
SECOND
THIRD
FOURTH
FIFTH
SIXTH
SEVENTH
LINCOLN
WASHINGTON
JEFFERSON
MADISON
DOUGLAS
MAIN
WEST
EAST
NORTH
SOUTH

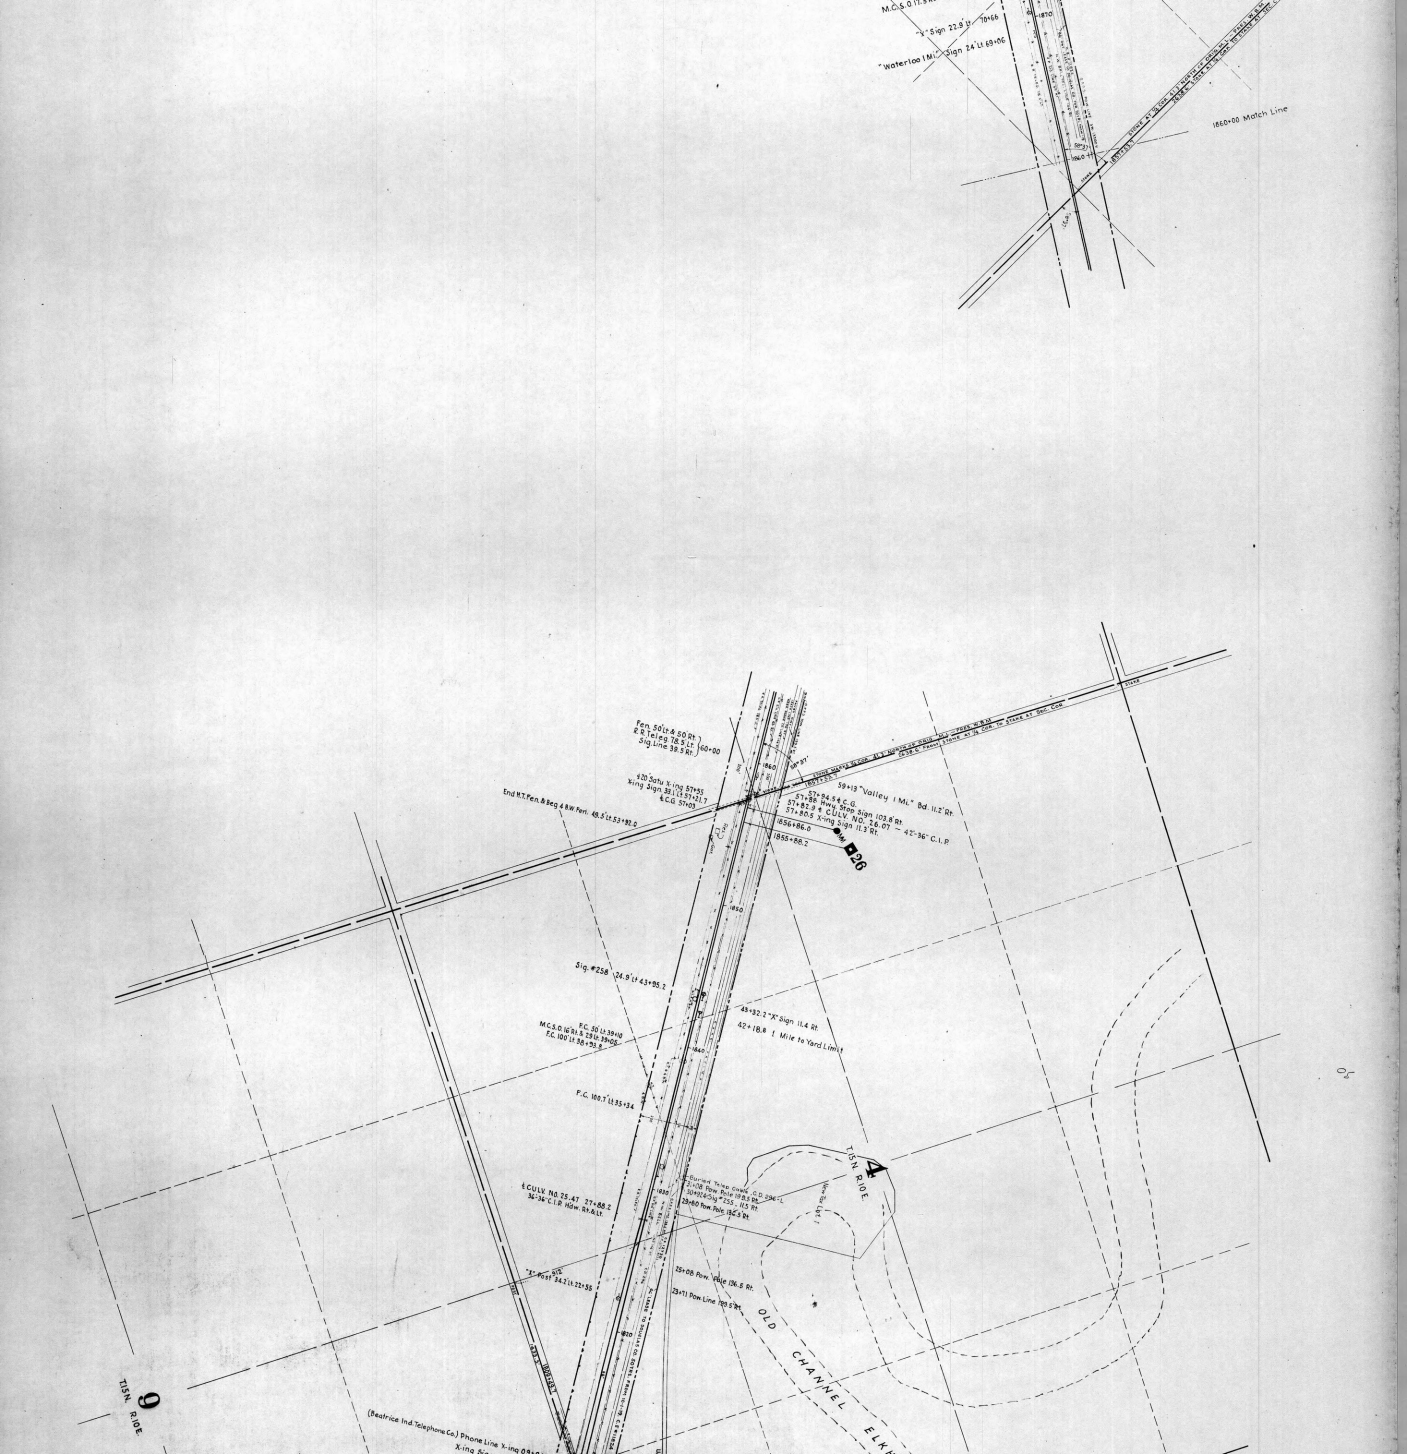
1660+00 Match Line
Fen. 50' Lt. & 50 Rt.
R.R. Tel. Pole 78' Lt. 160+00
Sig. Line 36.5 Rt.
420 Satu. X-ing 57+55
X-ing Sign 38' Lt. 57+51.7
E.C.U. 57+03
End N.T. Fen. & beg. 6 Bw Fen. 48.5' Lt. 53+90.0
57+94.5 E.C.U.
57+98 Head Wall
57+82.5 E.C.U. Mon. Sign 103.8 Rt.
57+80.5 X-ing Sign 11.5 Rt.
59+19 "Valley 1 Mi." Bd. 11.2' Rt.
1856+86.0
1855+88.2
B26
Sig. #258 24.9' Lt 43+95.2
M.C.& O. (6) & 39th 39+06
F.C. 100' Lt 38+35.8
F.C. 100.7' Lt 35+34
43+92.2 "X" Sign 11.4 Rt.
42+18.8 1 Mile to Yard Limit
E.CULV. NO. 25.47 27+88.2
36" C.I.P. HDw. Rt. & Lt.
"T" Post 34.2 Lt. 22+36
25+08 Pow. Pole 136.5 Rt.
23+71 Pow. Line 199.5 Rt.
T.15 N. R.10 E.
T.15N. R.9E.
OLD CHANNEL ELKHART RIVER
(Beatrice Ind. Telephone Co.) Phone Line X-ing 9&10
X-ing Sign


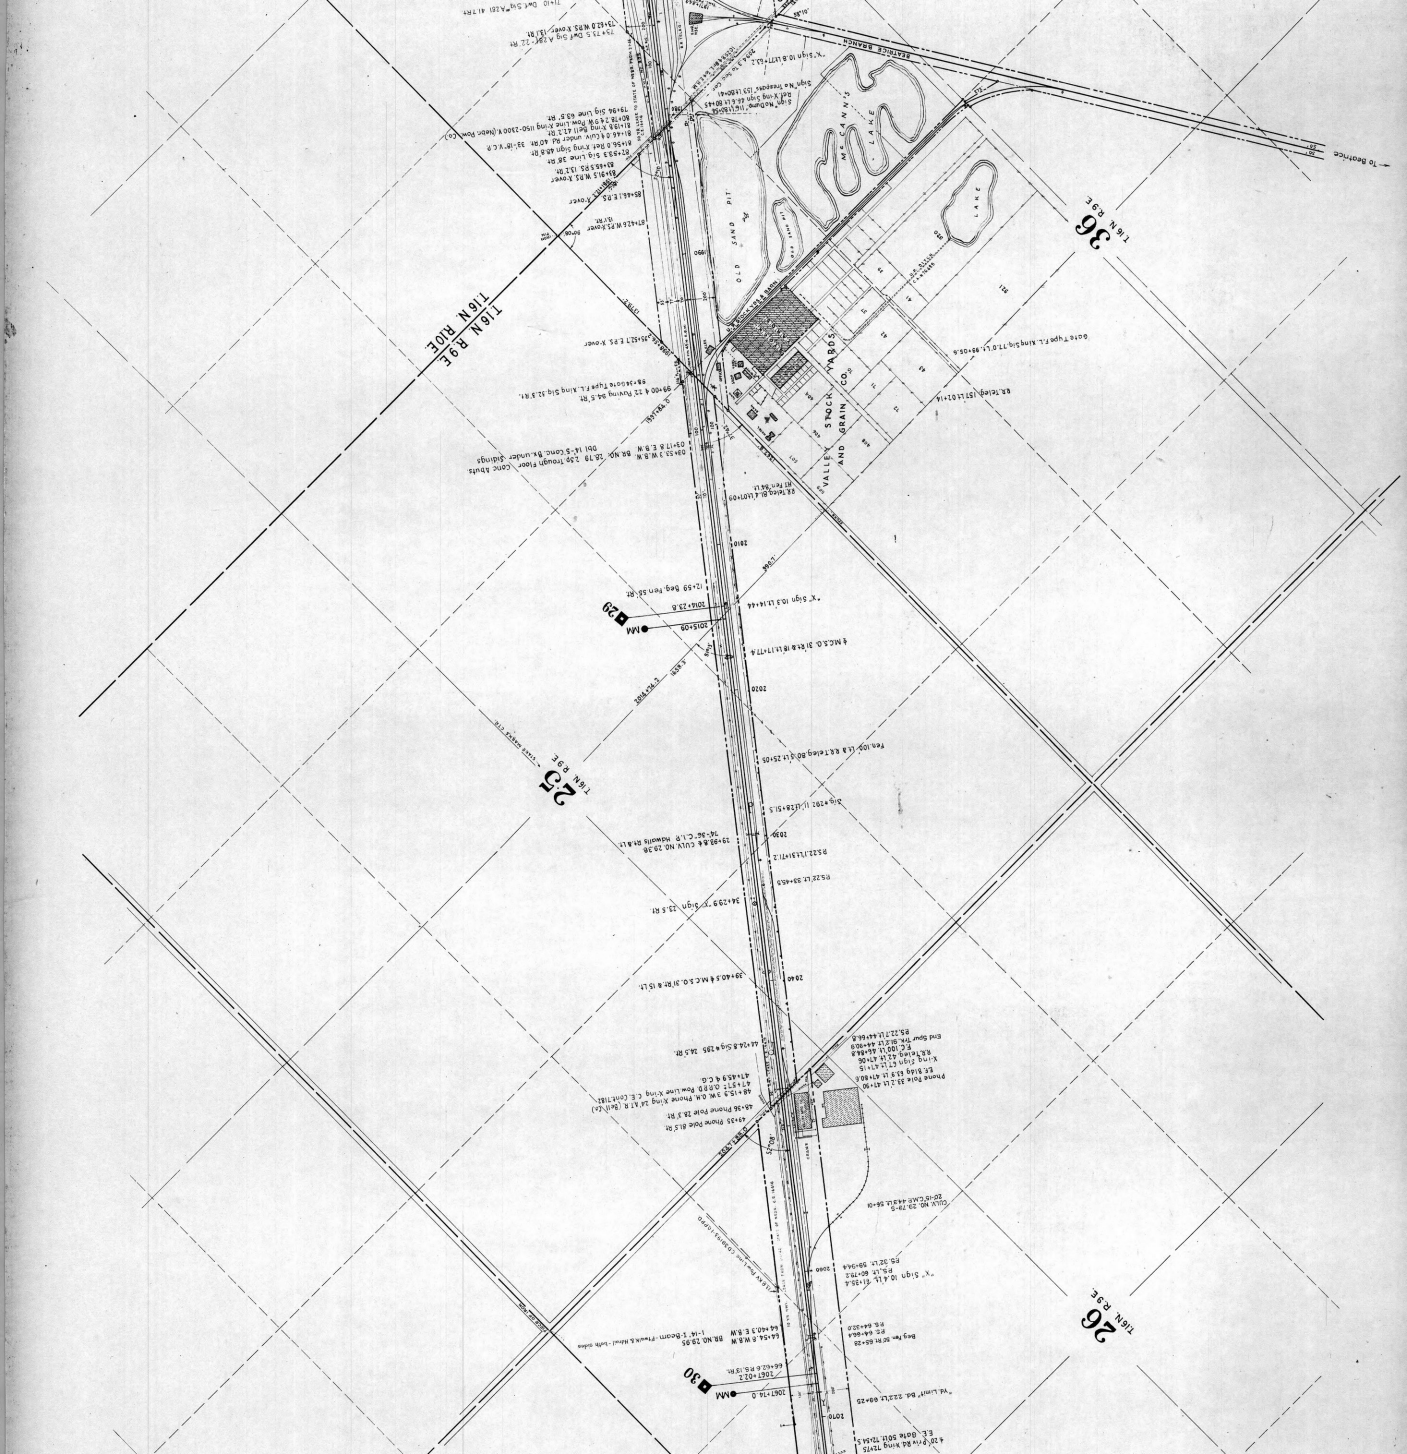
25
26
36
OLD SAND PIT
VALLEY STOCK YARDS AND GRAIN CO.

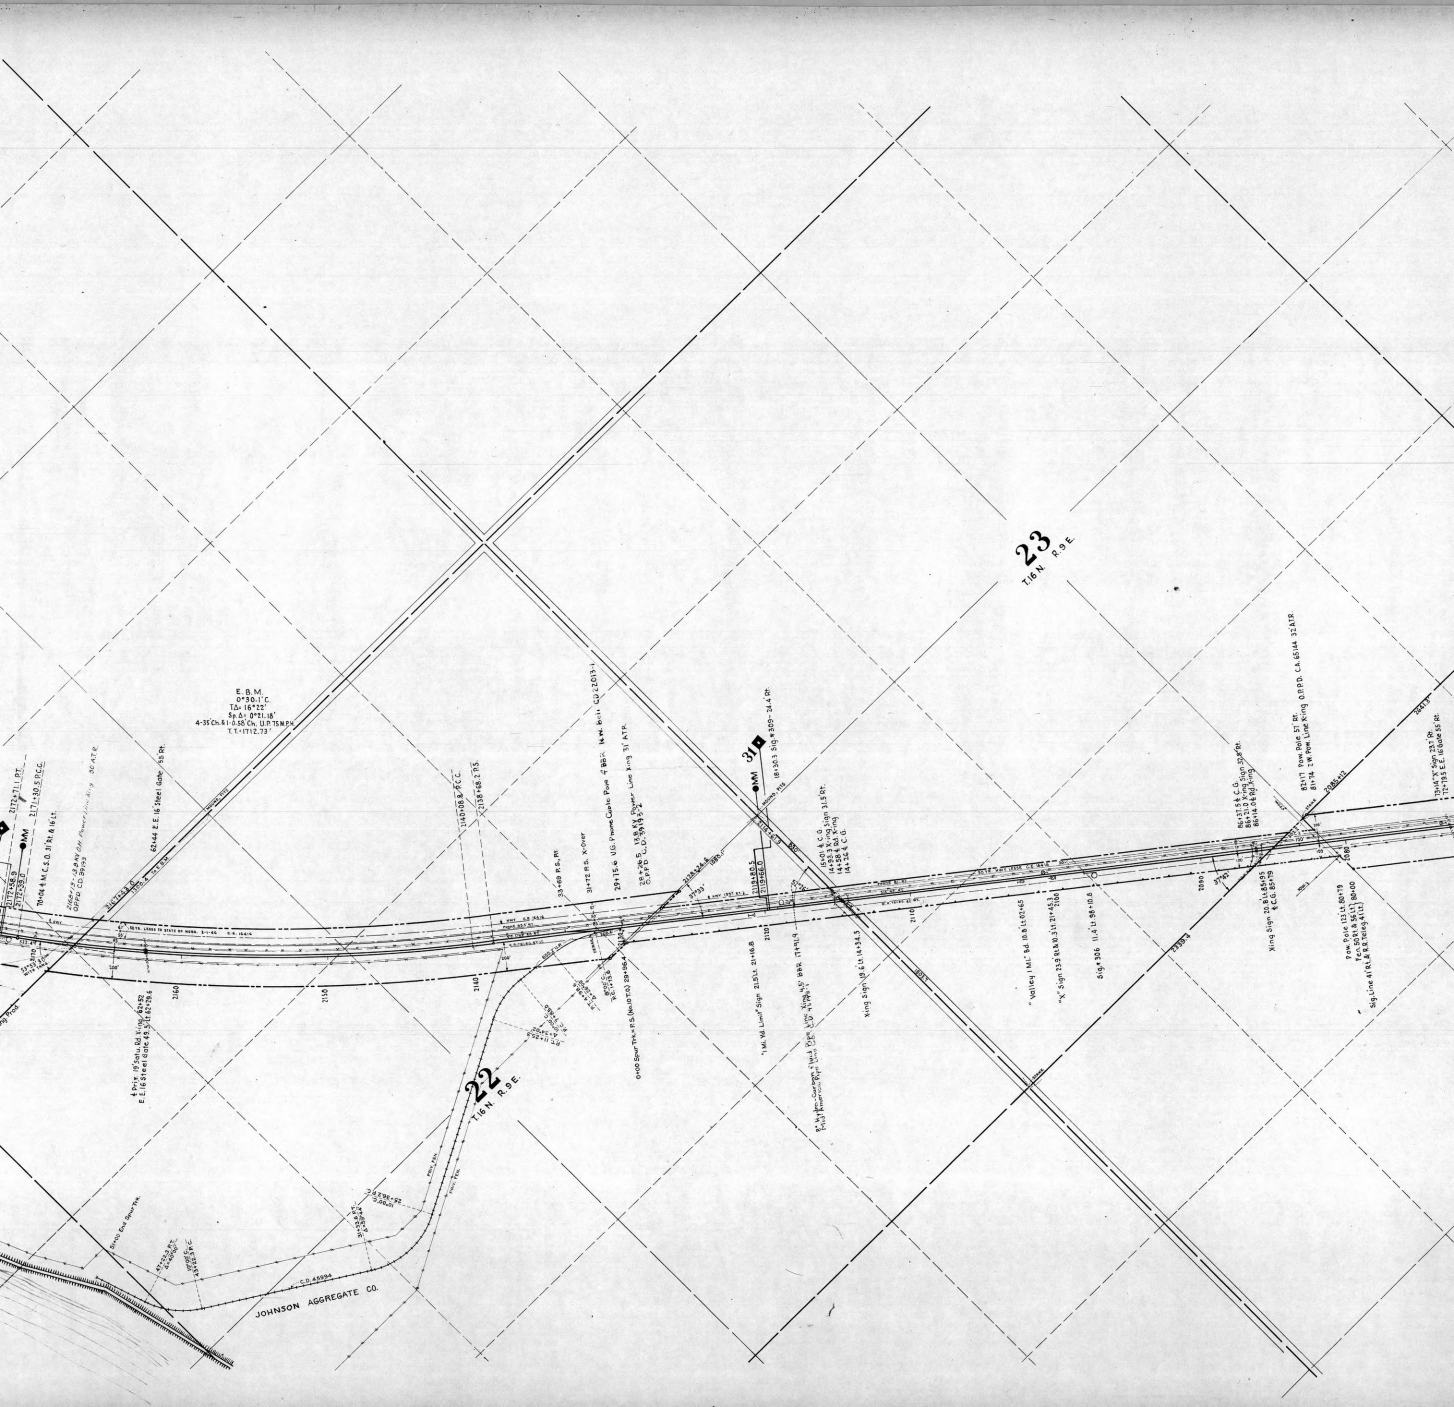
E. B. M.
6°30.1' C.
TΔ= 16°22'
Sp.Δ= 0°21.18'
4-35 Ch. 8 I-0.55 Cv. 11.11 TS M.P.N.
T.T.=1712.73'
23
T.16 N. R.9 E.
22
T.16 N. R.9 E.
JOHNSON AGGREGATE CO.

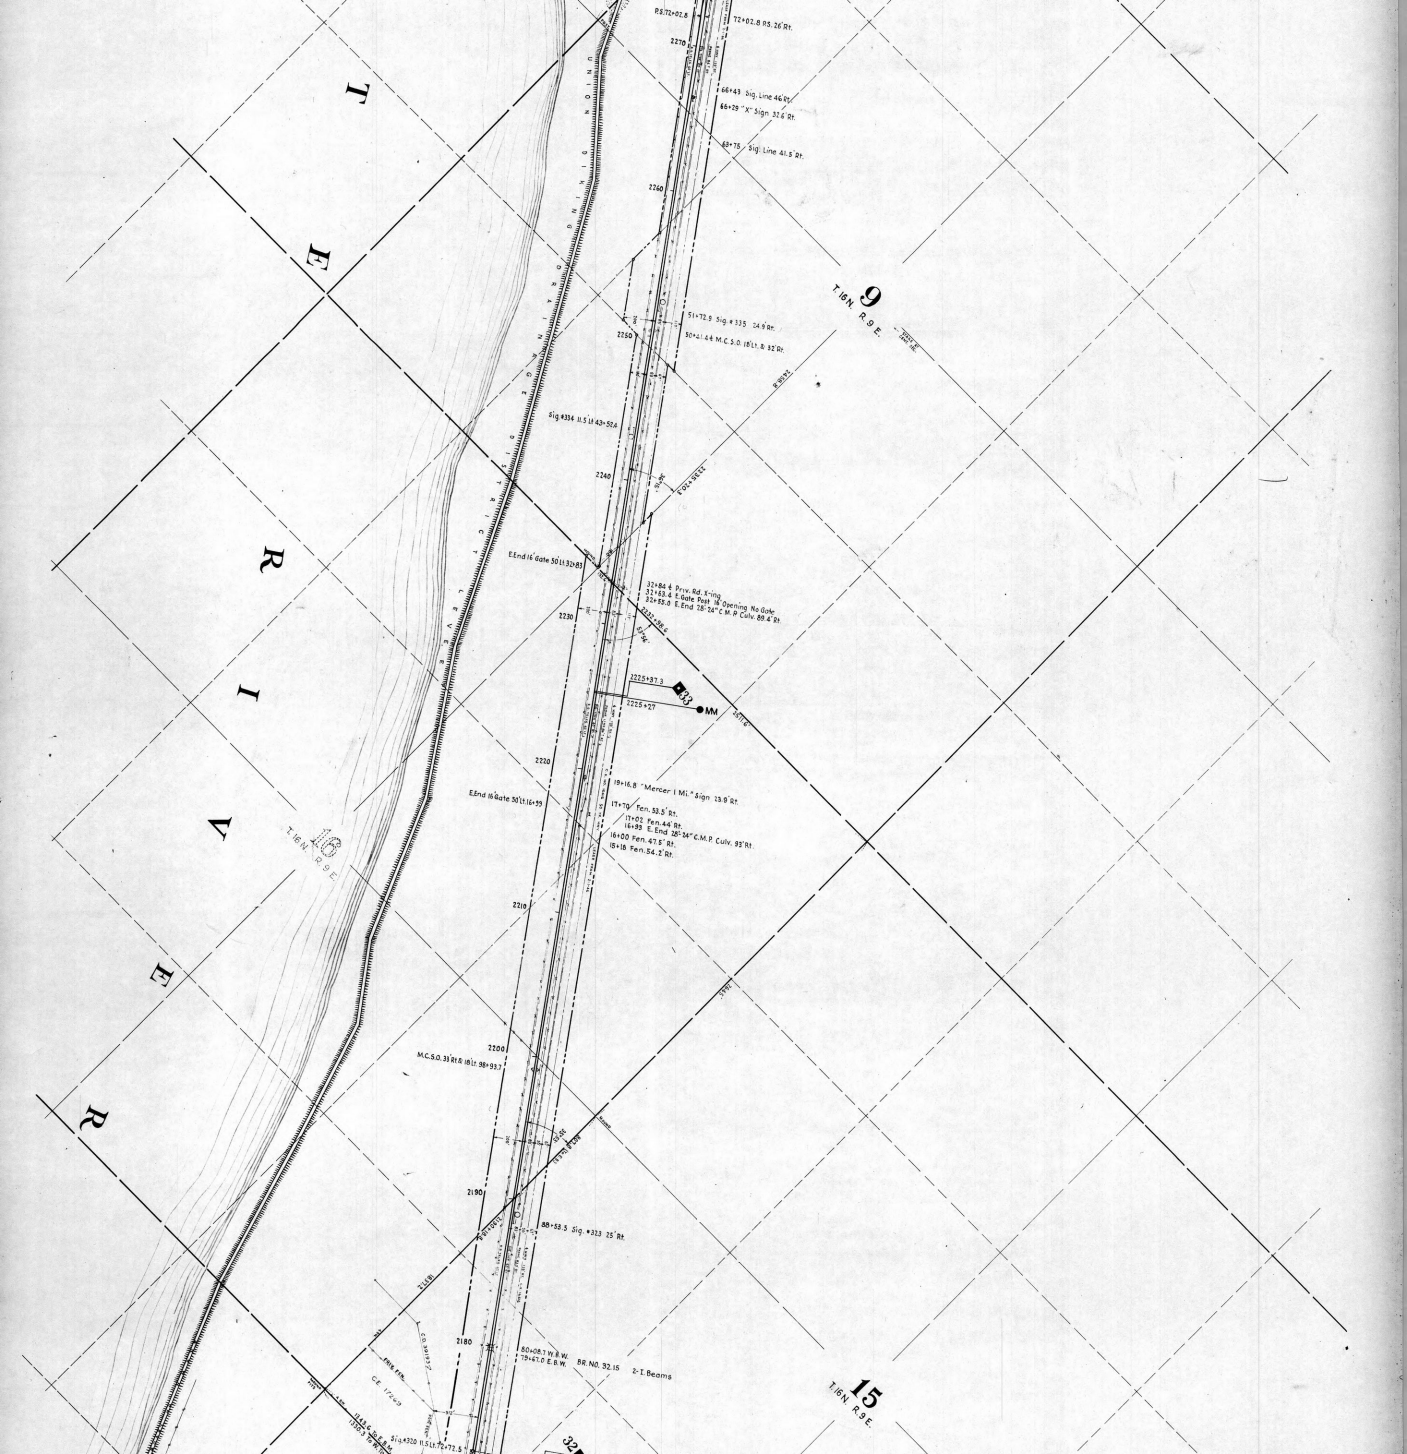
T 16N R 9 E
9
T 16N R 9 E
15
T 16N R 9 E
16
RIVER
R
E
Sig #334 11.5 Lt 43+50.6
E End 16' Gate 50 Lt 32+83
32+84.4 Prov. Rd. X-ing
32+69.4 E. Gate Post 16' Opening No Gate
32+55.0 E. End 28"-36" C.M.P. Culv. 89.4' Rt.
Prov. Rd.
MM
19+16.8 "Mercer I Mi." Sign 13.9' Rt.
17+70 Fen. 53.5' Rt.
17+02 Fen. 44' Rt.
16+35 E. End 28"-36" C.M.P. Culv. 93' Rt.
16+00 Fen. 47.5' Rt.
15+16 Fen. 54.2' Rt.
E End 16' Gate 50 Lt 16+55
M.C.S.O. 33 Rt. & 18 Lt. 98+93.7
88+52.5 Sig. #313 25' Rt.
80+08.7 W. B. W.
79+47.0 E. B. W.
BR. NO. 32.15
2- I. Beams
Sig #320 11.5 Lt. 72+72.5
72+02.8 R5.26' Rt.
R5.72+02.8
66+43 Sig. Line 46' Rt.
65+29 "X" Sign 32.4' Rt.
63+75 Sig. Line 41.5' Rt.
51+72.5 Sig. #335 24.9' Rt.
50+21.4 M.C.S.O. 18 Lt. & 32' Rt.
Fen. 48.2' Rt.
2270
2260
2250
2240
2230
2225+87.3
2225+27
2220
2210
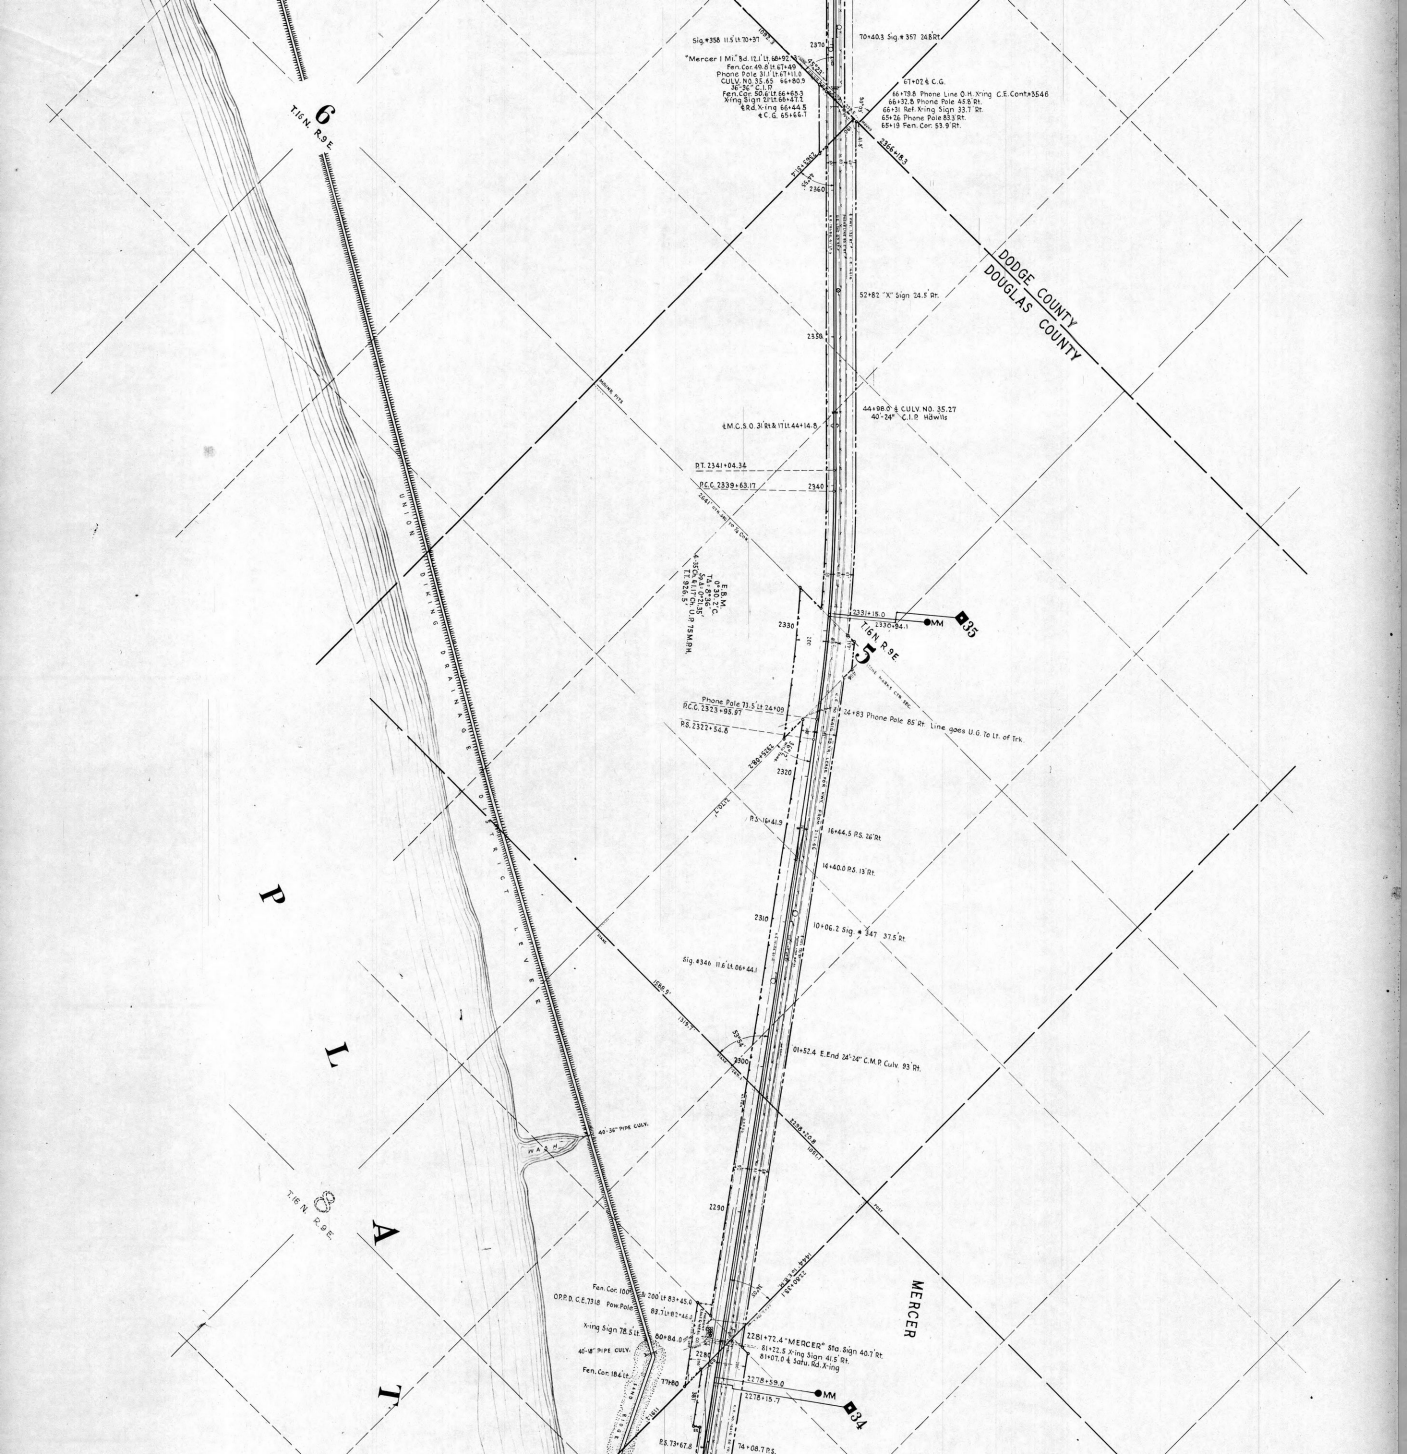
DODGE COUNTY
DOUGLAS COUNTY
MERCER
PLATTE
T16N R9E
"Mercer 1 Mi." Bd. 12.1' Lt. 60+92.4
Fen. Cor. 49.6' Lt. 67+69
Phone Pole 31.1' Lt. 67+11.3
CULV. NO. 35.40 64+80.9
36°-26° C.I.P.
Fen. Cor. 50.6' Lt. 66+65.3
Xring Sign 27.1' Lt. 66+47.5
R.R.& Xring 66+44.5
℄ C.G. 65+44.1
Sig.#358 11.5' Lt. 70+37.1
70+40.3 Sig.# 357 24.8' Rt.
67+07 ℄ C.G.
66+78.8 Phone Line O.H. Xring C.E. Cont.=3546
66+32.8 Phone Pole 46.8' Rt.
66+31 Rail Xring Sign 33.1' Rt.
65+26 Phone Pole 83.3' Rt.
65+19 Fen. Cor. 53.9' Rt.
52+82 "X" Sign 24.5' Rt.
44+98.0 ℄ CULV NO. 35.27
40°-24° C.I.P. Hdwlls
℄ M.C.S.O. 31.6' Rt. & 17' Lt. 44+14.8
P.T. 2341+04.34
P.C.C. 2339+63.17
2330+84.1
Phone Pole 73.5' Lt. 24+09
R.C.C. 2323+98.87
P.R. 2322+64.6
24+24+83 Phone Pole 85' Rt. Line goes U.G. To Lt. of Trk.
R.3-16°41.9
16+44.5 P.S. 26' Rt.
16+40.0 P.S. 13' Rt.
10+06.2 Sig. # 347 37.5' Rt.
Sig. 4346 11.6' Lt. 06+44.1
01+52.4 E. End 24°-34° C.M.P. Culv. 93' Rt.
40°-36° PIPE CULV.
Fen. Cor. 100' Lt. 83+45.6
OPP. B.C.E. 73+8
Pow. Pole 88.7' Lt. 81+87+44.2
Xring Sign 78.5' Lt. 80+84.0
40'-8° PIPE CULV.
Fen. Cor. 18.6' Lt.
77+90
2281+72.4 "MERCER" Sta. Sign 40.7' Rt.
81+22.5 Xring Sign 41.5' Rt.
81+07.0 ℄ Johnson Rd. Xring
2278+58.0
2278+15.7
83.73+67.8
74+08.7 P.S.
MM
35
34

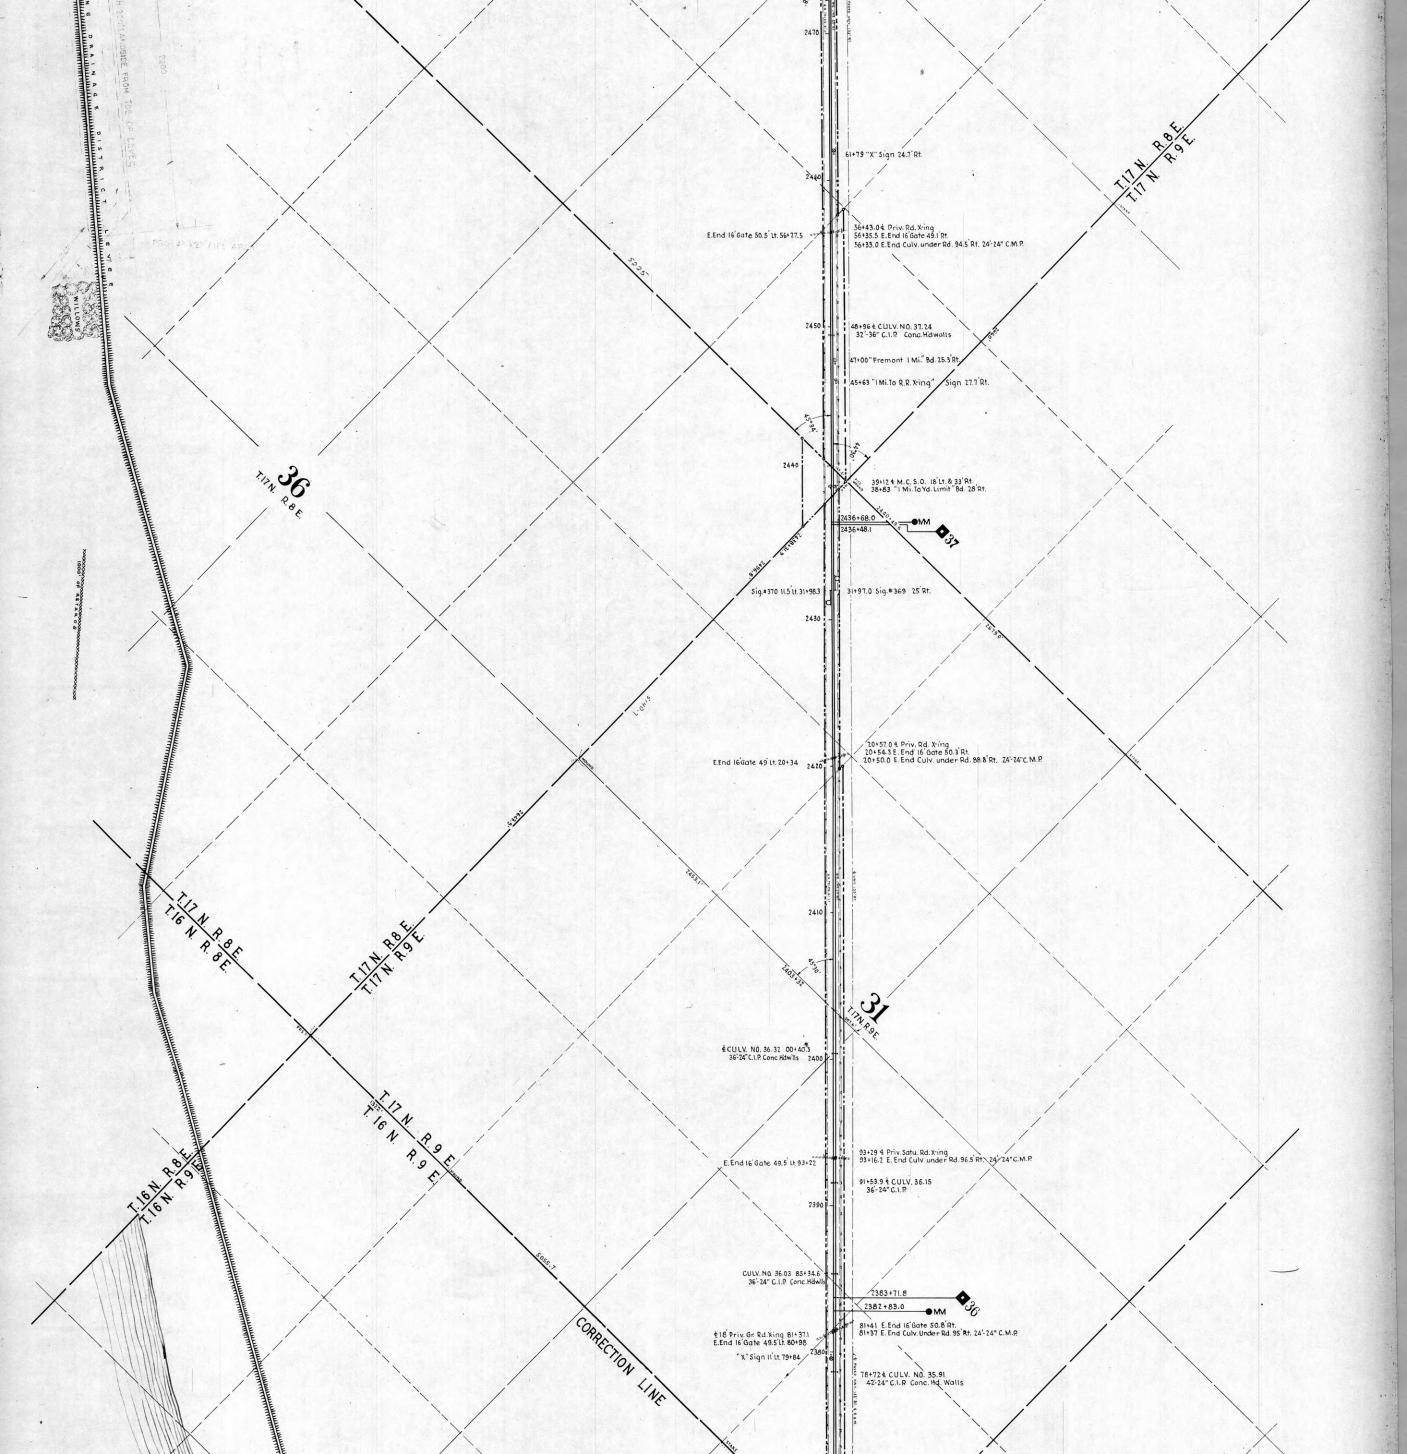
T.17N. R.8E.
T.17N. R.9E.
T.16N. R.8E.
T.16N. R.9E.
36
T.17N. R.8E.
31
T.17N. R.9E.
CORRECTION LINE
61+79 "X" Sign 24.1' Rt.
E.End 16' Gate 50.5' Lt. 56+37.5
36+43.0 ¢ Priv. Rd. X-ing
56+35.3 E. End 16' Gate 48.1' Rt
56+33.0 E. End Culv. under Rd. 94.5' Rt. 24°-24° C.M.P.
48+96.6 CULV. NO. 37.24
32"-36" C.I.P. Conc. Hdwalls
41+00 "Fremont 1 Mi." Bd. 35.5' Rt.
45+63 "1 Mi. To R.R. X-ing" Sign 27.3' Rt.
39+12.4 M.C.S.O. 18' Lt. & 33' Rt
38+83 "1 Mi. To Yd. Limit" Bd. 28' Rt.
2436+68.0
2436+48.1
MM
37
Sig.+370 11.5' Lt. 31+98.3
31+97.0 Sig.+369 25' Rt.
E.End 16' Gate 49' Lt. 20+34
20+57.0 ¢ Priv. Rd. X-ing
20+54.3 E. End 16' Gate 50.3' Rt.
20+50.0 E. End Culv. under Rd. 88.8' Rt. 24°-24° C.M.P.
¢ CULV. NO. 36.32 00+60.3
36"-24" C.I.P. Conc. Hdwlls.
93+29.9 ¢ Priv. Satu. Rd. X-ing
93+16.1 E. End Culv. under Rd. 96.5' Rt. 24°-24° C.M.P.
E.End 16' Gate 49.5' Lt. 93+22
91+53.9 ¢ CULV. 36.15
36"-24" C.I.P.
CULV. NO. 36.03 85+34.6
36"-24" C.I.P. Conc. Hdwlls
2382+71.8
2382+83.0
MM
30
¢ 16' Priv. Gr. Rd. X-ing 81+37.1
E.End 16' Gate 49.5' Lt. 80+88
81+41 E. End 16' Gate 50.8' Rt.
81+37 E. End Culv. Under Rd. 95' Rt. 24°-24° C.M.P.
"X" Sign 11' Lt. 79+84
76+72.4 CULV. NO. 35.91
42-24" C.I.P. Conc. Hd. Walls
2470
2460
2450
2440
2430
2420
2410
2400
2390
2380
S 2°25' E
S 87°35' E
N 87°35' W
S 87°35' E
S 87°35' E
S 87°35' E

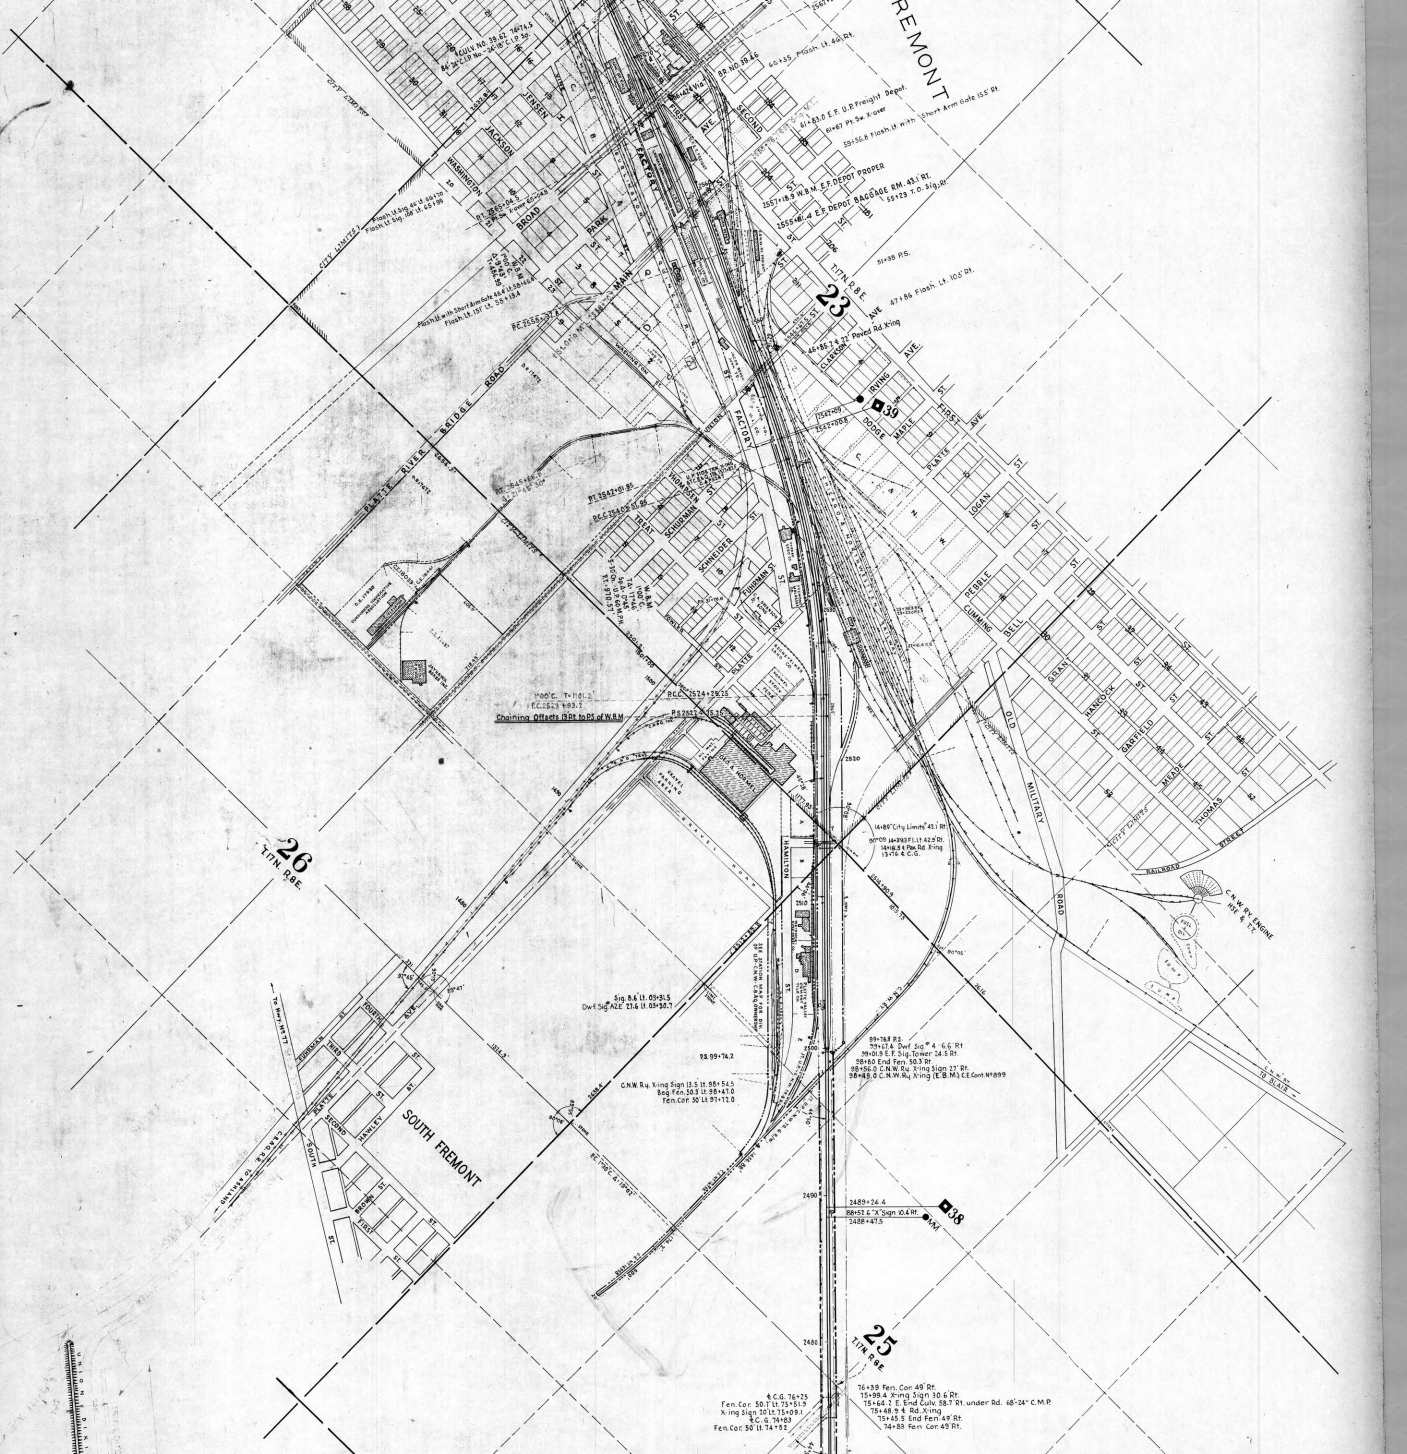
FREMONT
SOUTH FREMONT
MILITARY ROAD
RAILROAD
FACTORY
MAIN
BROAD
PARK
JACKSON
HAMILTON
CHURCH
SCHNEIDER
FISHER
WASHINGTON
SECOND
FIRST
LOGAN
PEBBLE
CUMMING
BELL
DEAN
HANCOCK
GARFIELD
MELROSE
THOMAS
STREET
26 T17N R8E
23 T17N R8E
25 T17N R8E
39
38
Sig. 8.6 Lt. 09+31.5
Dwf. Sig. ACE 21.6 Lt. 03+36.7
98.99+74.2
C.N.W. Ry. X-ing Sign 13.5 Lt. 98+54.5
Beg. Fen. 50.5 Lt. 98+47.0
Fen. Cor. 50 Lt. 97+11.0
2489+24.4
R8452.6 "X" Sign 10.4 Rt.
2488+47.5
76+39 Fen. Cor. 49' Rt.
75+98.4 X-ing Sign 30.6 Rt.
75+64.3 E. End Culv. 58.7 Rt. under Rd. 68°-24' C.M.P.
75+48.9 4 Rd. X-ing
75+45.5 End Fen. 49 Rt.
74+89 Fen. Cor. 49 Rt.
4 C.G. 76+25
Fen. Cor. 50 T. Lt. 75+51.9
X-ing Sign 30 Lt. 75+09.1
4 C. G. 74+83
Fen. Cor. 50 Lt. 74+55.2

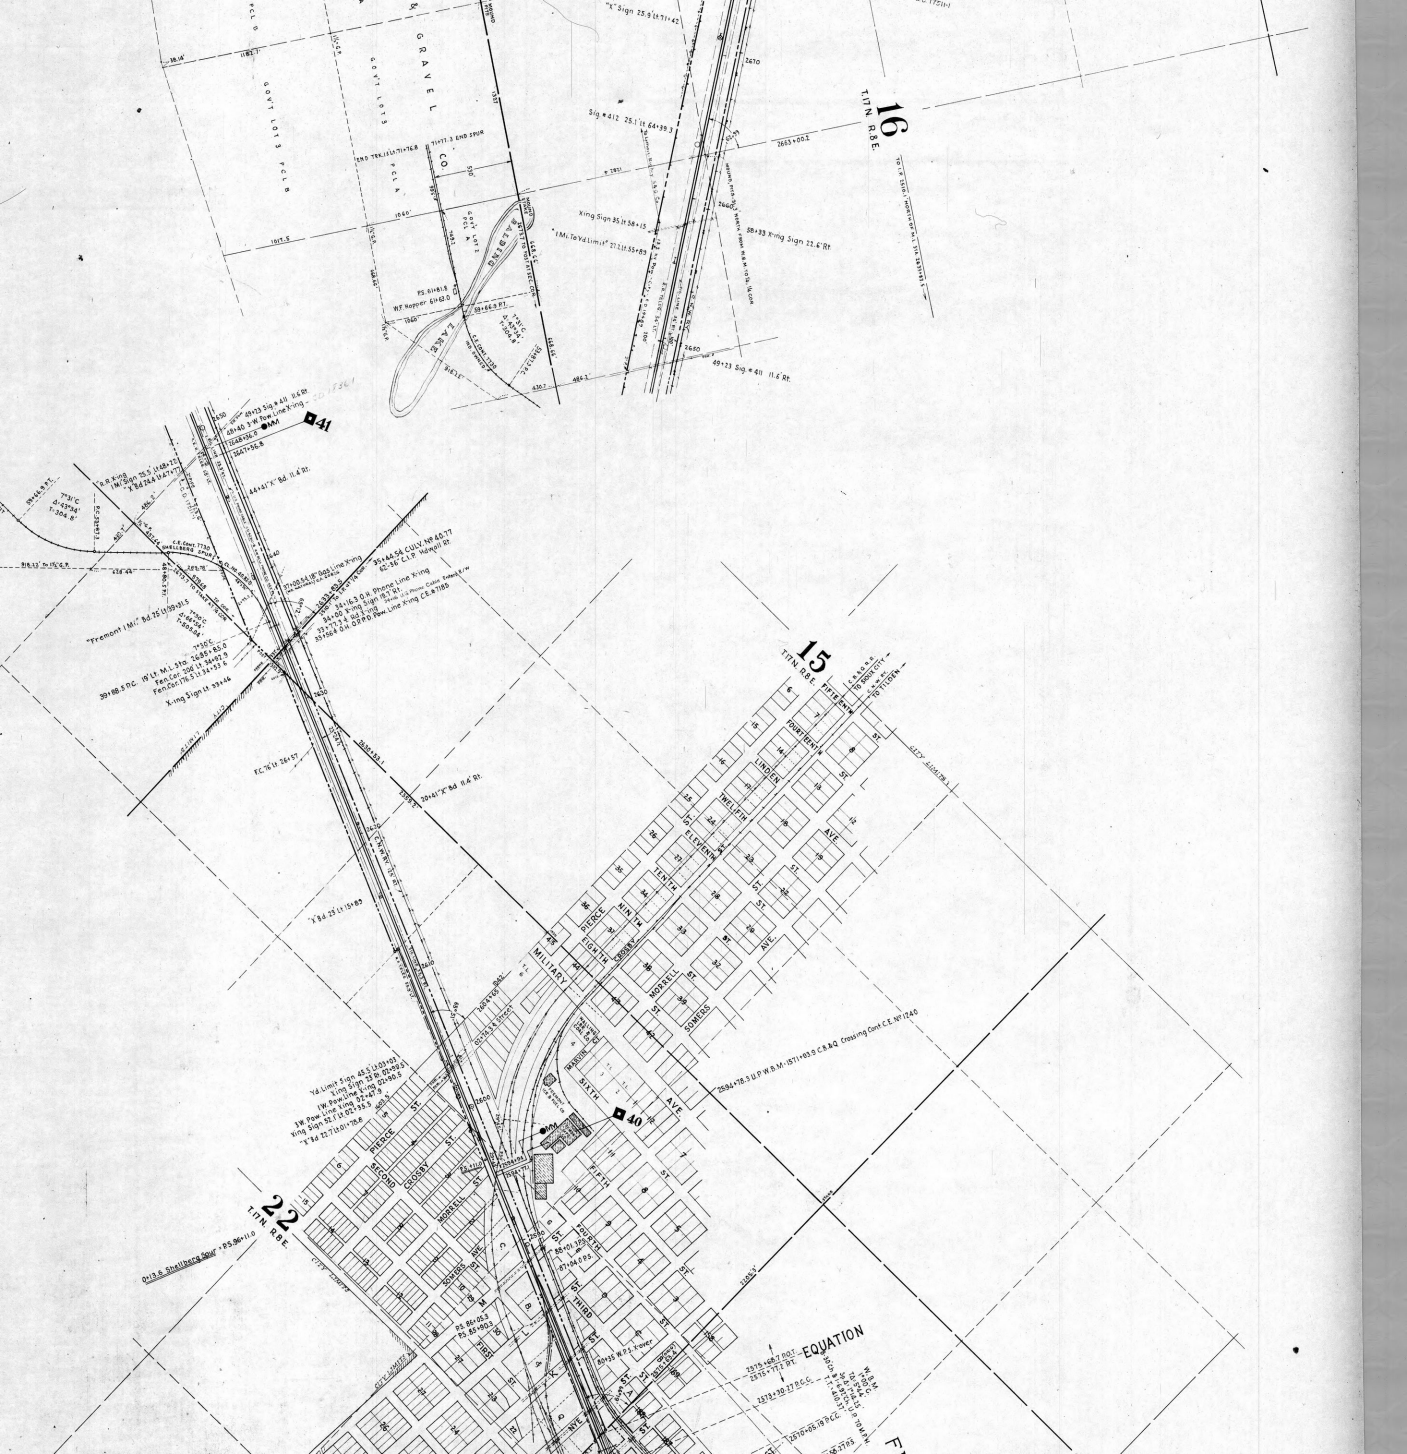
16
T.17N. R.8E.
15
T.17N. R.8E.
22
T.17N. R.8E.
41
40
GRAVEL
GOVT LOT 5 PCL B
GOVT LOT 6
PCL A
EQUATION
FIRST AVE
SECOND AVE
THIRD AVE
FOURTH AVE
FIFTH AVE
SIXTH AVE
SEVENTH AVE
EIGHTH AVE
NINTH AVE
TENTH AVE
ELEVENTH AVE
TWELFTH AVE
MILITARY
PIERCE
MORRELL
SOMERS
LINDEN
MAIN ST
Fremont I.M.L. Bd. 25' Lt. 39+31.5
Xing Sign Lt 39+46
Sig. ø 412 25.1' Lt. 64+39.3
Xing Sign 35' Lt 58+13
58+33 Xing Sign 22.4' Rt
49+23 Sig. ø 411 11.6' Rt
W.F. Hopper: 61+62.0
Crossing Cont C.E. N° 1240

SHELBERG SAND





























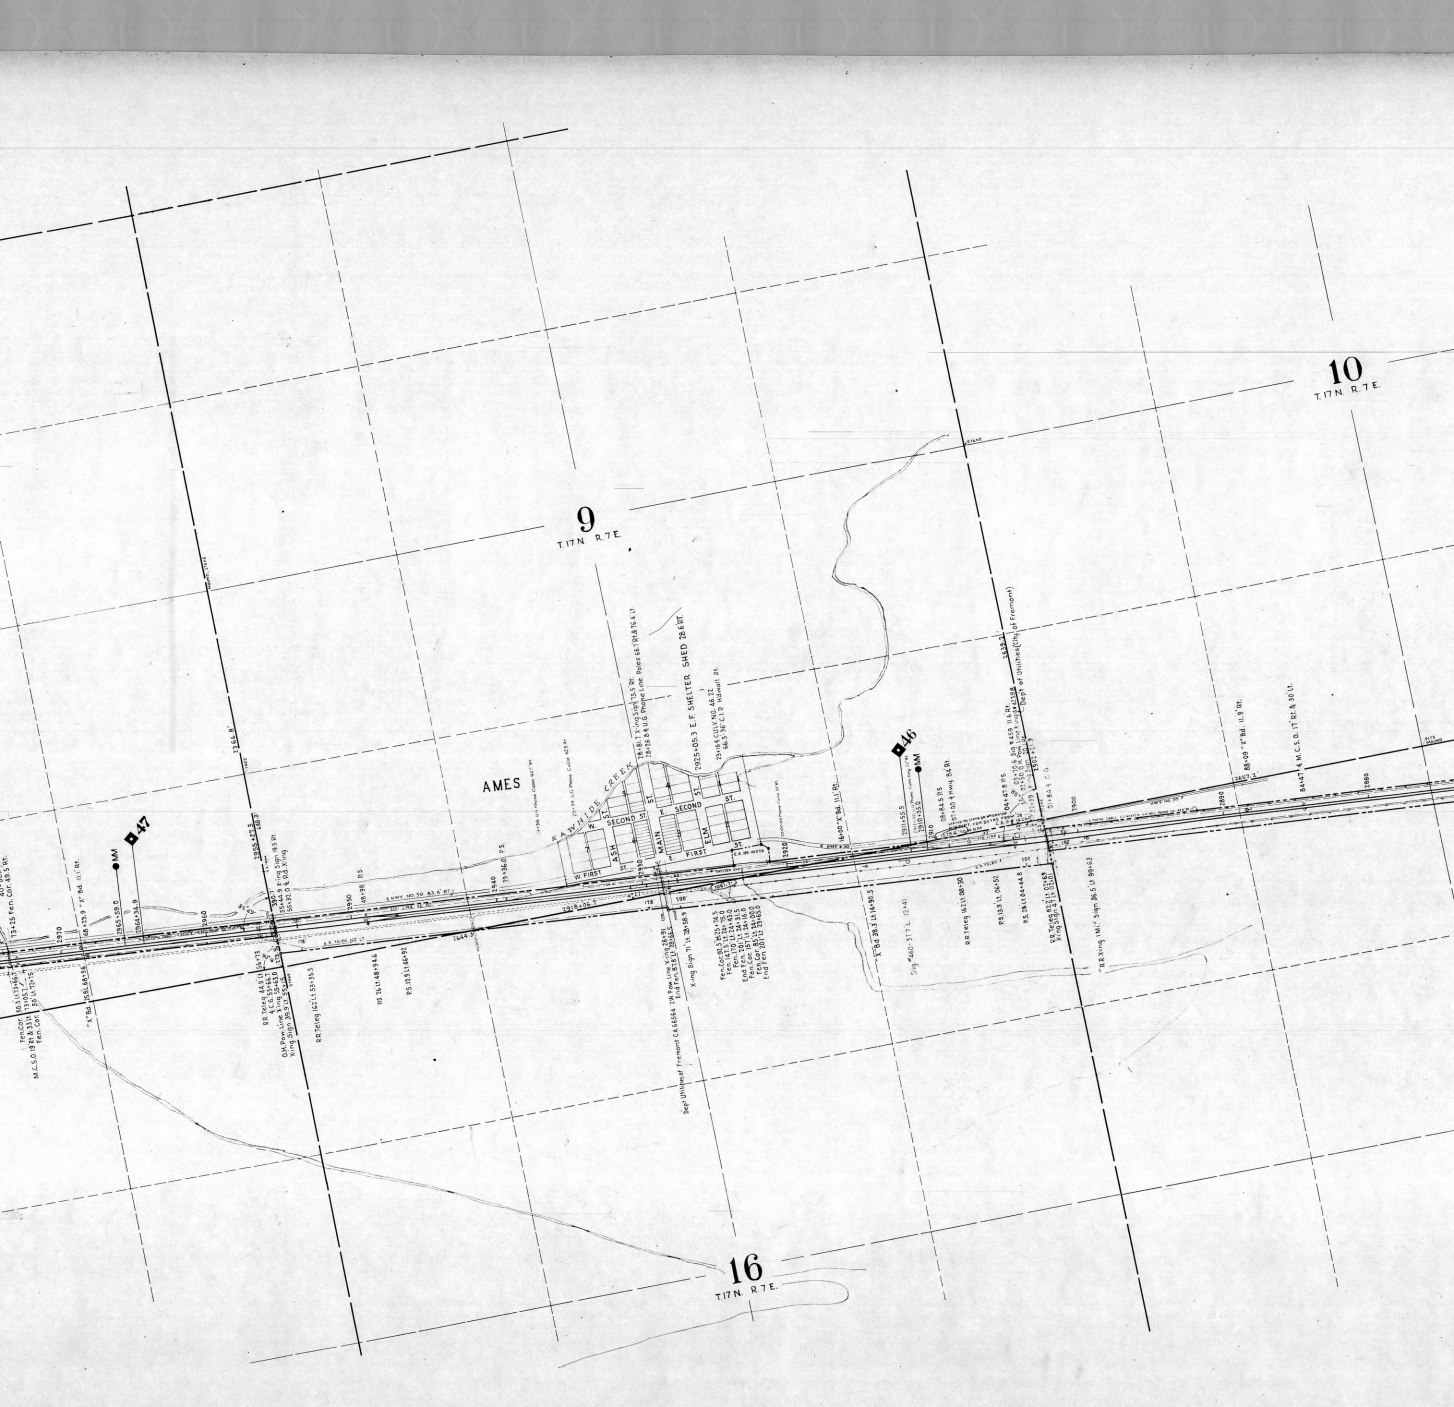
10
T.17N. R.7E.
9
T.17N. R.7E.
16
T.17N. R.7E.
AMES
SECOND ST
MAIN ST
ASH AVE
WALNUT
FIRST ST
ELM ST
W. FIRST ST
47
46

T17N R7E

T17N R6E

T17N R7E

8

7

CENTRAL CUT-OFF DITCH

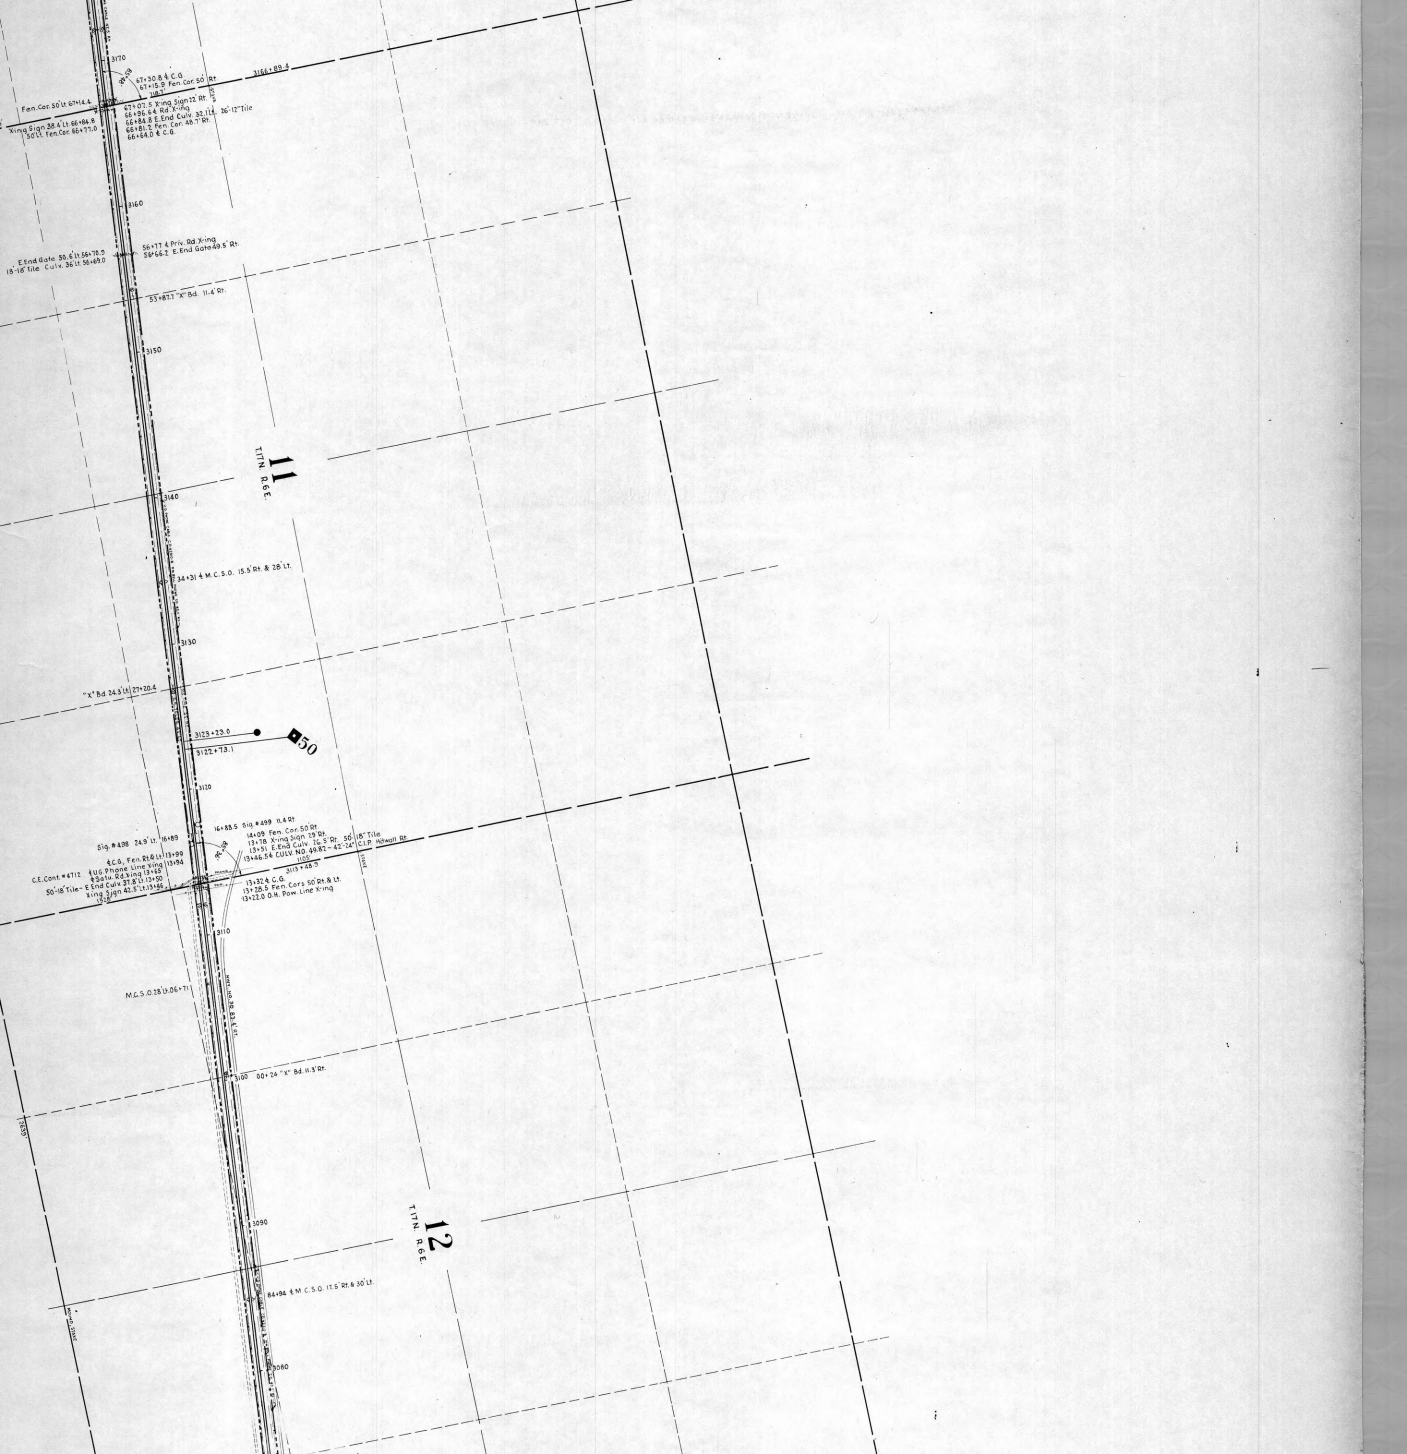
3170
3160
3150
3140
3130
3120
3110
3100
3090
3080
67+30.8 C.O.
67+15.9 Fen Cor 50 Rt
Fen Cor 30 Lt 67+14.4
Xing Sign 38.4 Lt 66+86.8
30 Lt. Fen Cor. 66+77.0
274.01 S Xing Sign 12 Rt.
66+96.4 Rd X-ing
66+84.8 E.End Culv. 32 Lt.
66+81.3 Fen Cor. 45.7 90
66+64.0 C.O.
36"-12" Tile
3166+89.4
E.End Gate 59.6 Lt 56+78.9
18"-18" Tile Culv. 36 Lt 56+69.0
56+77.4 Priv. Rd Xing
56+66.2 E.End Gate 60.5 Rt.
53+87.3 "X" Bd. 11.4 Gr.
34+31.4 M.C.S.O. 15.5 Rt. & 28 Lt.
"X" Bd 24.3 Lt 27+20.4
3123+23.0
3122+73.1
50
16+88.5 Sig.#499 11.4 Gr
14+09 Fen. Cor. 50 Gr.
13+78 Xing Sign 19 Gr.
13+51 E.End Culv. 15.5 Dr. 50-18" Tile
13+46.54 CULV. NO. 99 82°-42'-24" C.I.P.
3115+28.7
13+32.4 C.O.
13+28.5 Fen. Cors 50 Rt. & Lt.
13+22.0 O.H. Pow. Line X-ing
Sig.#498 24.9 Lt 16+89
C.E. Cont.#4712
4 C.O. Fen. 21.6 Lt 13+90
4 U.G. Phone Line X-ing 13+90
4 Batt. Rd X-ing 13+65
E.End Culv. 27.8 Lt 13+50
X-ing Sign 42.5 Lt 13+66
50-18" Tile
M.C.S.O. 28 Lt 06+71
00+24 "X" Bd. 11.5 Rt.
84+94.4 M.C.S.O. 17.0 Rt. & 30 Lt.

UNION PACIFIC RAILROAD

NEBRASKA DIVISION -- MAIN LINE

LANE TO BEYOND AMES

DOUGLAS & DODGE COUNTIES, NEBRASKA

M. P. 17.7 to M. P. 31.0
Station 1400 00 to Station 3180 00
Section 22, T. 15 N., R. 11 E. to Section 11, T. 17 N., R. 6 E.

Scale 1" = 400'

Office of Chief Engineer, U.P.R.R., Omaha, Nebr., July 1, 1952
Platted from former maps, C. E. Dwgs. No. 13528, and No. 20694, "As Constructed" Work Order prints to date, and Resurvey of 1950-51, Nebr. Div. Notebooks 1699, 1703 and 1877

PLATTED BY	TRACED BY	CHECKED BY
I. M. S.	I. M. S.	

CHECKED AS TO
RIGHT OF WAY BY DATE

C. E. DWG. NO. 80543
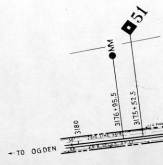
Corrected to