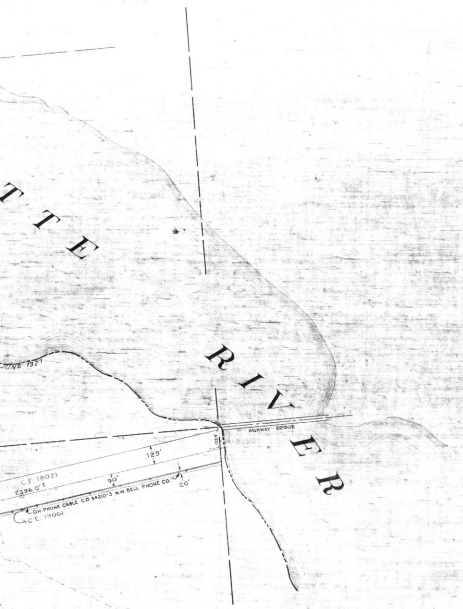

UNION PACIFIC RAILROAD

NEBRASKA DIVISION — MAIN LINE

NORTH PLATTE TO PAXTON

KEITH & LINCOLN COUNTIES, NEBRASKA

M. P. 281.94 to M. P. 316.61

Station 17365+00 to Station 17195+00

SECTION 35, T. 14 N., R. 30 W. to SECTION 5, T. 13 N., R. 35 W.

Scale 1" = 400'

Office of Chief Engineer, U.P.R.R., Omaha, Nebr., Jan. 6, 1950

Platted from former maps C. E. Dwg. No. 13876 & 19742. "As Constructed" Work Order prints to date. Letter of 3-30-46 C. E. File A.10620. & Resurvey of 1948-1949 Nebr. Div. Notebooks No. 1847, 1848, 1861, 1866, 1869 & 1870.

PLATTED BY	TRACED BY	CHECKED BY
IMS	IMS	JEV

CHECKED AS TO RIGHT OF WAY BY R. L. F. DATE 4-26-50

C. E. DRAWING NO. 80232

Corrected to

E. SEWER DISPOSAL PLANT W/MUNICIPAL
ED IN SEC 5 T-13N R-35W

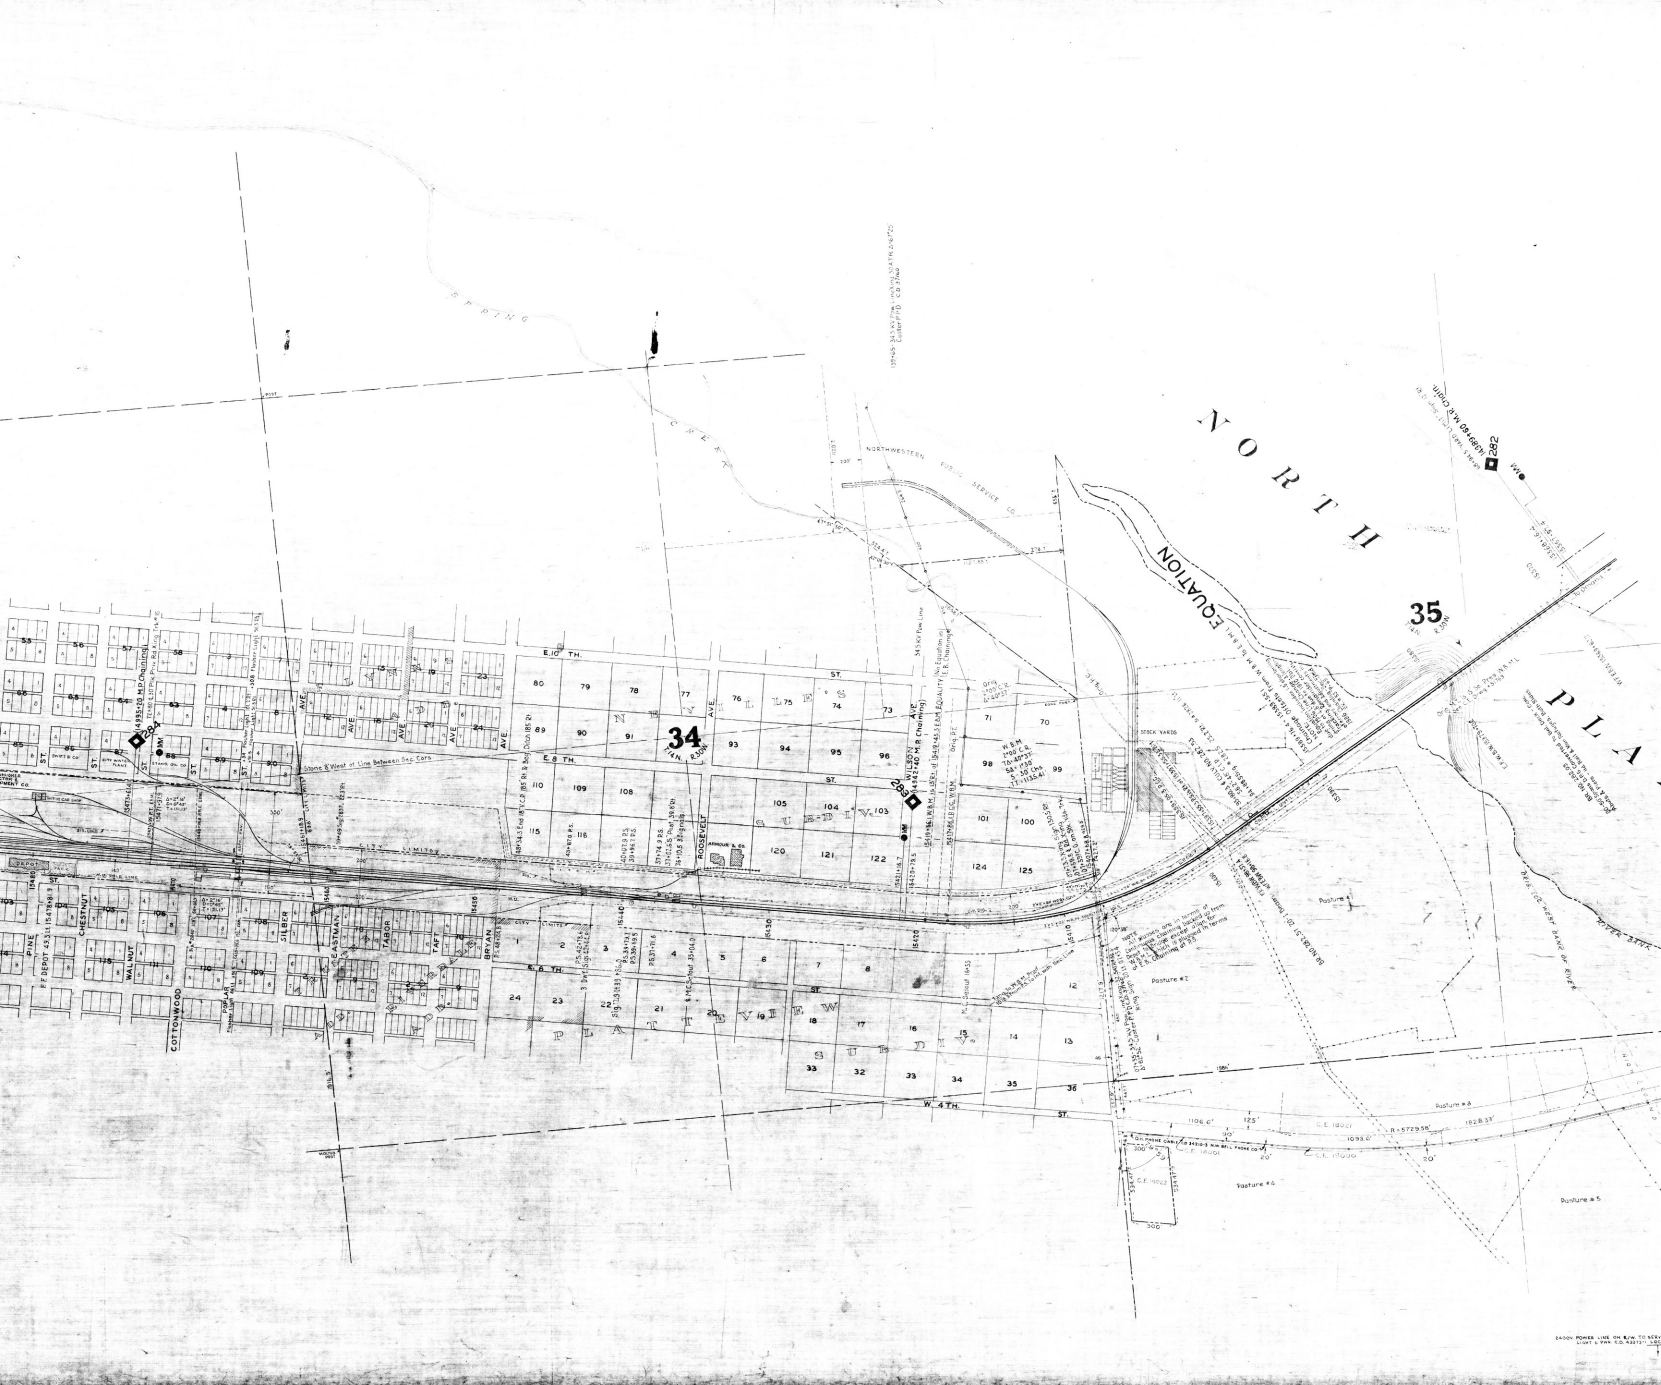
NORTH
PLA
EQUATION
35
34
282
283
284
NORTHWESTERN PUBLIC SERVICE CO.
E. 10 TH. ST.
E. 8 TH. ST.
E. 6 TH. ST.
W. 4 TH. ST.
PINE
CHESTNUT
WALNUT
COTTONWOOD
POPLAR
SILBER
EASTMAN
TABOR
TAFT
BRYAN
ROOSEVELT
Pasture #1
Pasture #2
Pasture #3
Pasture #4
Pasture #5
Pasture #6
Stock Yards
Storm 8' West of Line Between Sec Cors
EADON POWER LINE ON R/W TO SCEV
LIGHT & PWR CO. 422121 LAND

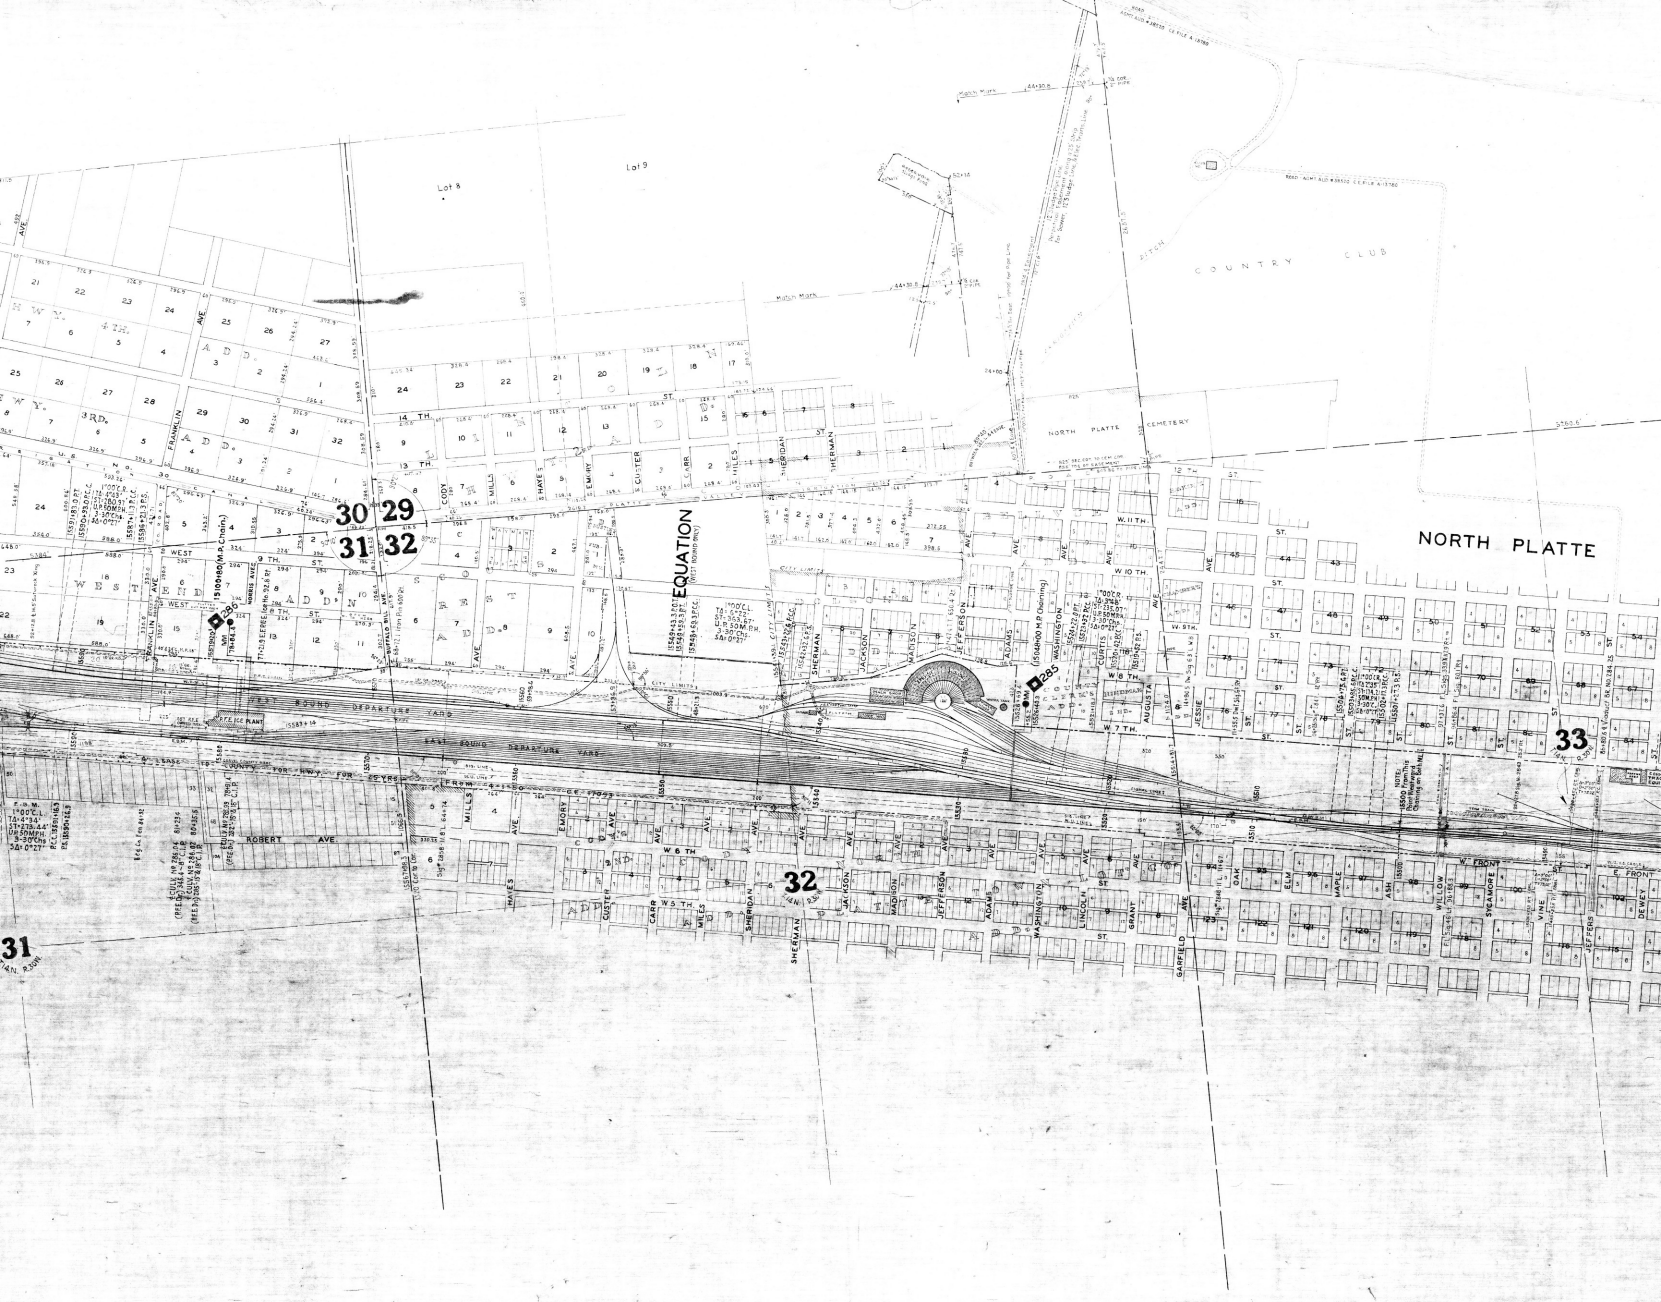

C.E. Cont #5378
Northwestern Public Service Co.
Maint. of U.P. Teleph. Wires on Serv. Cos. Poles to Pumping Sta. on Platte River 4-15-25

Agmt. Aud. #38520 C.E. File A-13780
North Platte Country Club
Use of Road to Reach U.P. Pump. Sta.
4-1-34 To Term 30 Days From Written Notice

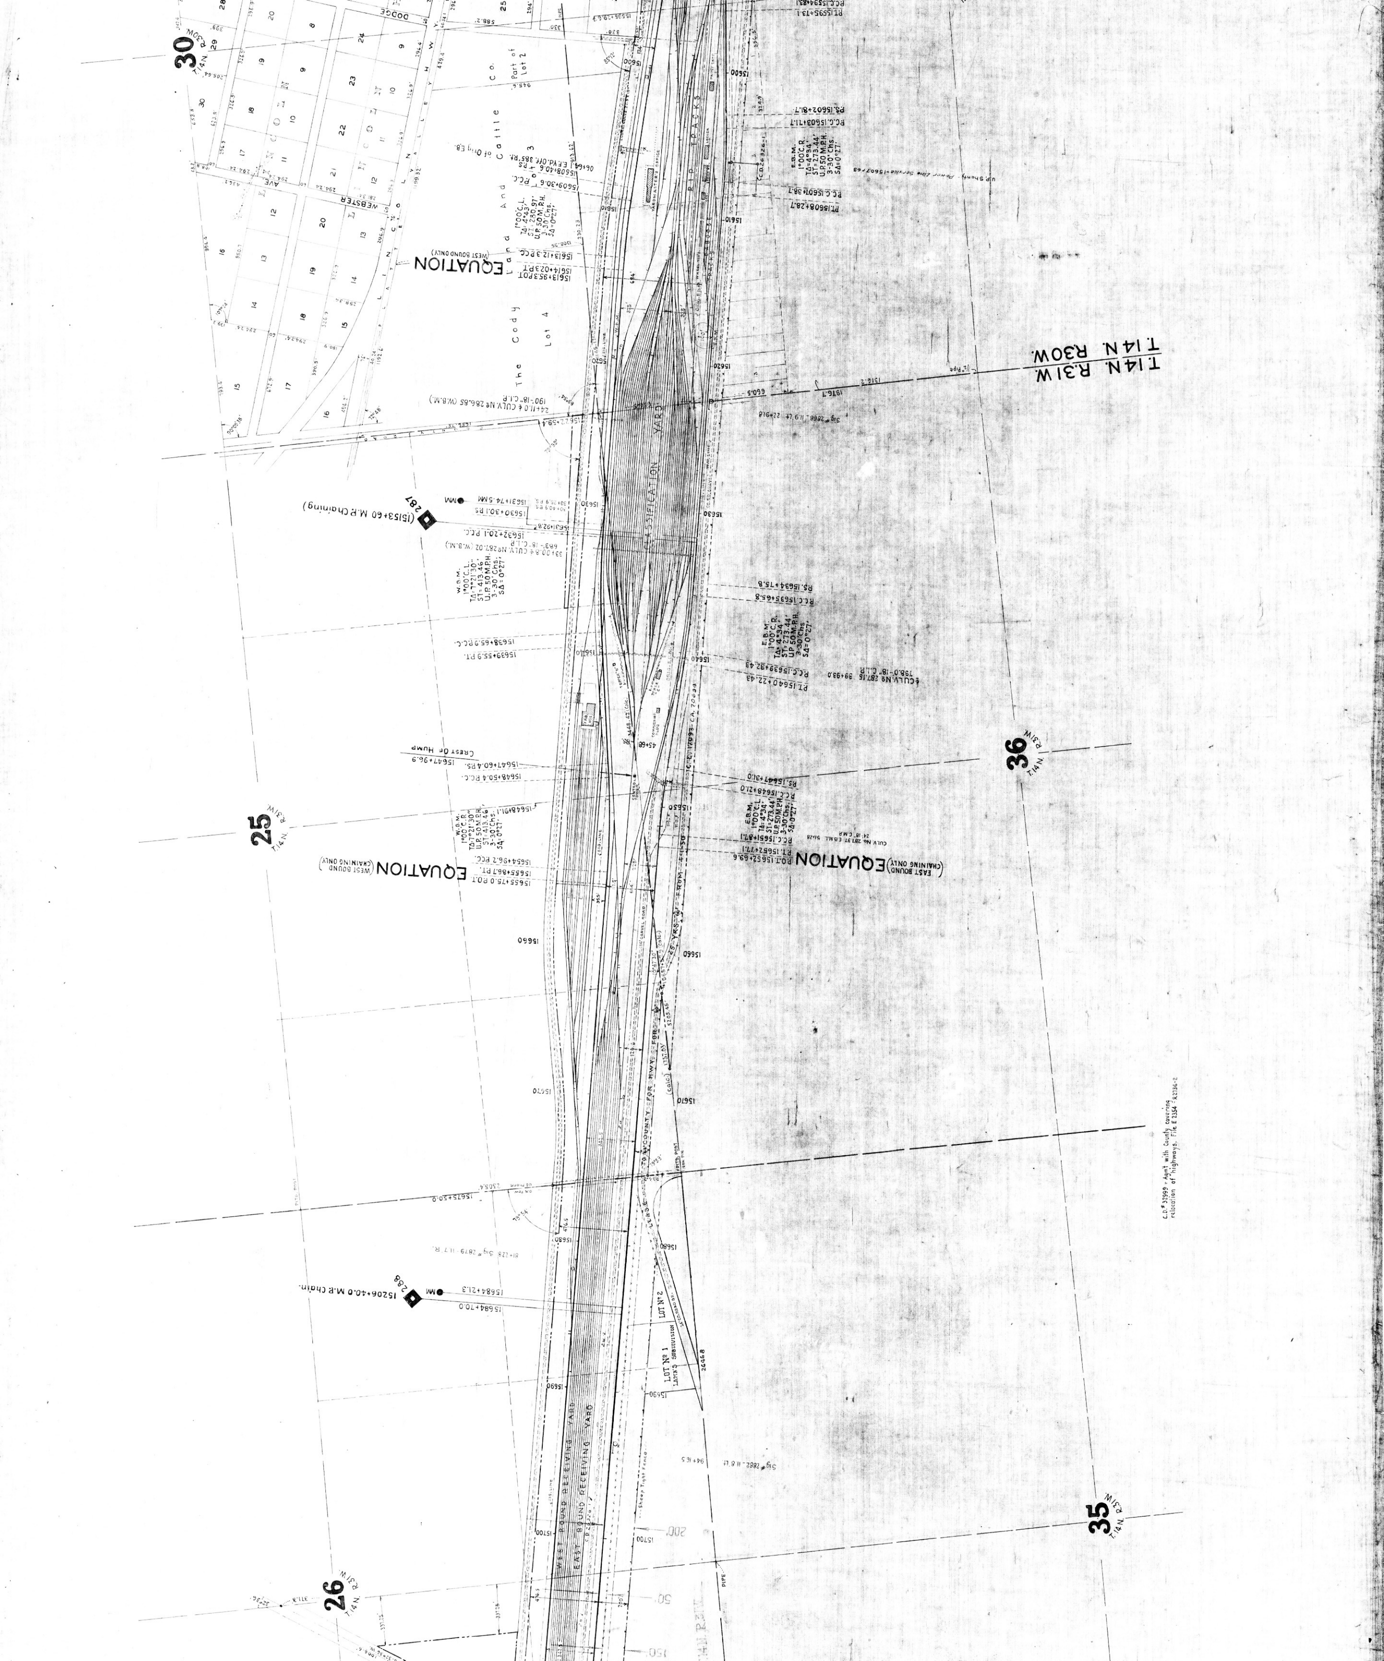
T.14N. R.30W.
T.14N. R.31W.
30
25
26
36
35
CLASSIFICATION YARD
RIP TRACKS
CABOOSE TRACKS
WEST BOUND RECEIVING YARD
EAST BOUND RECEIVING YARD
EQUATION (WEST BOUND ONLY)
15613+95.3 P.O.T.
15614+02.3 P.T.
15613+12.3 P.C.C.
EQUATION (WEST BOUND CHAINING ONLY)
15655+75.0 P.O.T.
15655+86.7 P.T.
15654+96.2 P.C.C.
EQUATION (EAST BOUND CHAINING ONLY)
P.O.T. 15652+69.6
P.T. 15652+77.1
P.C.C. 15651+87.1
287 (15153+60 M.P. Chaining)
288 15206+40.0 M.P. Chain.
15647+96.9 Crest Of Hump
The Cody Land And Cattle Co.
Lot 4
Part of Lot 2
DODGE
WEBSTER AVE.
LINCOLN
LOT No 1 LAYNE'S SUBDIVISION
LOT No 2
TO COUNTY FOR HWY
Sheep Tight Fence
U.P. Shanty - Power Line Service - 15607+63
C.D.# 32999 - Agm't with County covering relocation of highways. File E 2354 - R2736-2

BIRDWOOD

28

18+00.0 ℄ 12' Rd. 82' Rt.
17+84.7 "BIRDWOOD" Sta. Sign 46' Lt.
E.F. DEPLT. (Edit + 48.5 Kilfried)
16+11.3 P.S.
16+20.0 ± m Sig. Pole Line 42' Rt.

07+97
07+90.0 ℄ 24' Saturac Rd. X'ing

4'12' Rd. 63.5' Lt. 07+67.3

4'12' Rd. 73' Lt. 09+00.0

Sig. No. 29.0.2 33.7' Lt. 98+41.5

P.S. 13' Lt. 97+22.3
M.C.S.O. 97+06.8

4'12' Rd. 65' Lt. 95+00.0

95+15.4 P.S. Rt. & Lt.
94+44.3 Sig. No. 29.0.1 12.2' Rt.

15790+24.4 15712+00 M.P. Chain.
15790
15789+21.3 MM

4'12' Rd. 76.5' Lt. 90+00.0

"V.D. L.I.M." 33.5' Lt. 84+47.6

4'12' Rd. 73.5' Lt. 84+00.0

15782+06.3
885.1'

4'12' Rd. 63.7' Lt. 80+00.0

LINCOLN COUNTY DRAINAGE DISTRICT CANAL 157

72+70.5 ℄ M.C.S.O.

67+36 Sign "Sw. Limits" 9' Rt.

(+8) 3 Fen. Cor. 50' ℄ Rt.
(+72.) Fen. Cor. 100' Rt.

27

EQUATION

15756+16.6 P.O.T. W.B.M. (Orig. M.L.)
15756+69.6 P.T. W.B.M. is 13' Rt. of 15756+37.4 E.B.M.

NOTE:
Stationing on E.B.M. ends 13' Lt. at P.T. W.B.M. - Stationing Continues on W.B.M. west of this Point

15756+37.4

15755+29.6 P.C.C.

34

(E.B.) 15750

15750 (W.B.)

Sig. # 28.3.2 123' Lt. 48+37.0
(E.B.) P.S. 47+71.3

41+80.7 Train Order Rd. 31.3' R.
41+73.9 Lt. Pole 23' R.

15748+41.3 P.C.C.

15747+01.3 P.S.

6+54.3 P.S. (W.B.)

P.T. 15746+19.84

P.T. Orig. M.L.

P.C.C. 15743+93.3

"X" Rd. 10.5' Lt. 43+45.0

42+95.4 Sig. # 28.8.1 13' R. & Dwf. H.L.

15740

P.C. Orig. P.C.C.

P.C.C. 15738+22.34

15737+47.2

15259+20 M.P. Chain.
MM

P.S. 15736+99.84

15733+57.1 P.T.

15730+42.1 P.C.C.
4027.9' From E.B.M. To Sec. Cor.

4 C.G. 29+80.0
4 30" Culvert 2+100 29+96.6
X'ing Sign 28.4' Lt. 29+18.5

15730

15729+84.2 (W.B.)

30+10.0 C.G.
30+06.7 X'ing Sign 17.1' Rt.
29+92.5 ℄ 30" Saturac X'ing

15728+50 (E.B.)
941.5'

BR. No. 288.78
2-24' I Beams

NBW 26+31.2
EBW 26+23.0

26+36.4 ℄ CULV. No. 288.78 (on W.BM.)
24.1-17' Conc. Culv. also 44.1-17' Conc. Culv. ℄ under Trks. 325 & 327
Roadway Bridges, Rt. & Lt.

15723+45.8 P.C.C.

15720+28.8 P.S.

15720

Fen. Cor. 85' Lt. 18+62.0

Fen. Cor. 50' @ 84.5' Lt. 12+38.0
Fen. Cor. 91' Lt. 12+30.6
200' Lt. 10+45.0

15710

31+94.3 ℄ M.C.S.O. Rt.&Lt.

15930

21+38.74 Irrig. Ditch 73' Rt.
21+08.6 ℄ Conc. Down Drop (Weir) in Irrig. Ditch 59.8' Rt.
16+85.3 ℄ CULV. Nº 232.58
44-24" Dbl. 24" C.I.P. (Conc. E. Walls (Irrig.)

End Rd. 62' Lt. 75+00

℄ Sig. No. 2926 246' Lt 22+26.5

22+26.0 ℄ Sig. No. 2925 12' Rt.

15920

412' Road 53.0' Lt. 15+00

12+86.5

M.C.S.O. Rt.& Lt. 11+72.0

30

15910

15900

15885+80.1 15417+60 M.P. Chain.
15835+46.0 282 BM

412' Road. 63.5' Lt. 95+00

"ONE MILE TO STA." Bd. 23.5' Lt. 93+83.0

93+40.04 15 Saturoc Priv. Rd. X-ing, Gate 50' Rt.

15880

15886+43.6

28+41.9

24+95.6

15880

M.C.S.O. Lt. & Rt. 71+31.5

15870

61+40.5 ℄ Sig. No. 2913 11.6' Rt.

60+24

℄ Sig. No 2914 25' Lt. 61+41.6

29

15860

60+41.5 P.S.

50+50 Fen. 50' Rt.

15850

47+14.4 Fen. Cor. 225' Rt., & M.C.S.O. Rt. & Lt.
47+10.8 Fen. Cor. 80' Rt., 20' Gate

"S" Post 34.2' Lt. 47+29.3

15843+02.1 15364+80 M.P. Chain.
15842+82.8 283 BM

42+87.8 Sec. Marker 12.5' Rt. 194 192

P.S. 1.1 Rt. 40+72.1

15840

P.S. 13.1 Lt. 38+56.8
"ONE MILE TO YD. LIN." Sign 35.0' Lt. 38+45.0

℄ C.G. 34+28.2
℄ R.R. & 4 W. X-ing 34+25.5
424' Saturoc ℄ & X-ing 33+88.5
℄ X-ing Sign 51.1' Lt. 33+72.5
℄ C.G. 33+58.8

34+54.0 End Spur 33.8' Rt.
15835+95.6

34+41.0 Fen. Cor. 225' Rt.
34+07.3 X-ing Sign 26.0' Rt.

31+67.0 E.F.W.B. 31+54.7 Rd. 193.5' Rt.
BR. NO. 290.78
31+39.0 W.F.E.B. 1-14' I.B.G. Ft. W.X. & Hdrail Both Sides

31+23.1 P.S.
30+92.1 ℄ CULV. Nº 190.77
48-24" C.I.P.

15830

29+12.5 ℄ in Sig. Pole Line 161.2' Rt.

25+25.0 ℄ in Sig. Pole Line 185.1' Rt.

23+00.0 ℄ 12' Rd. 177' Rt.
23+00.0 ℄ in Sig. Pole Line 86' Rt.

COUNTY

LINCOLN

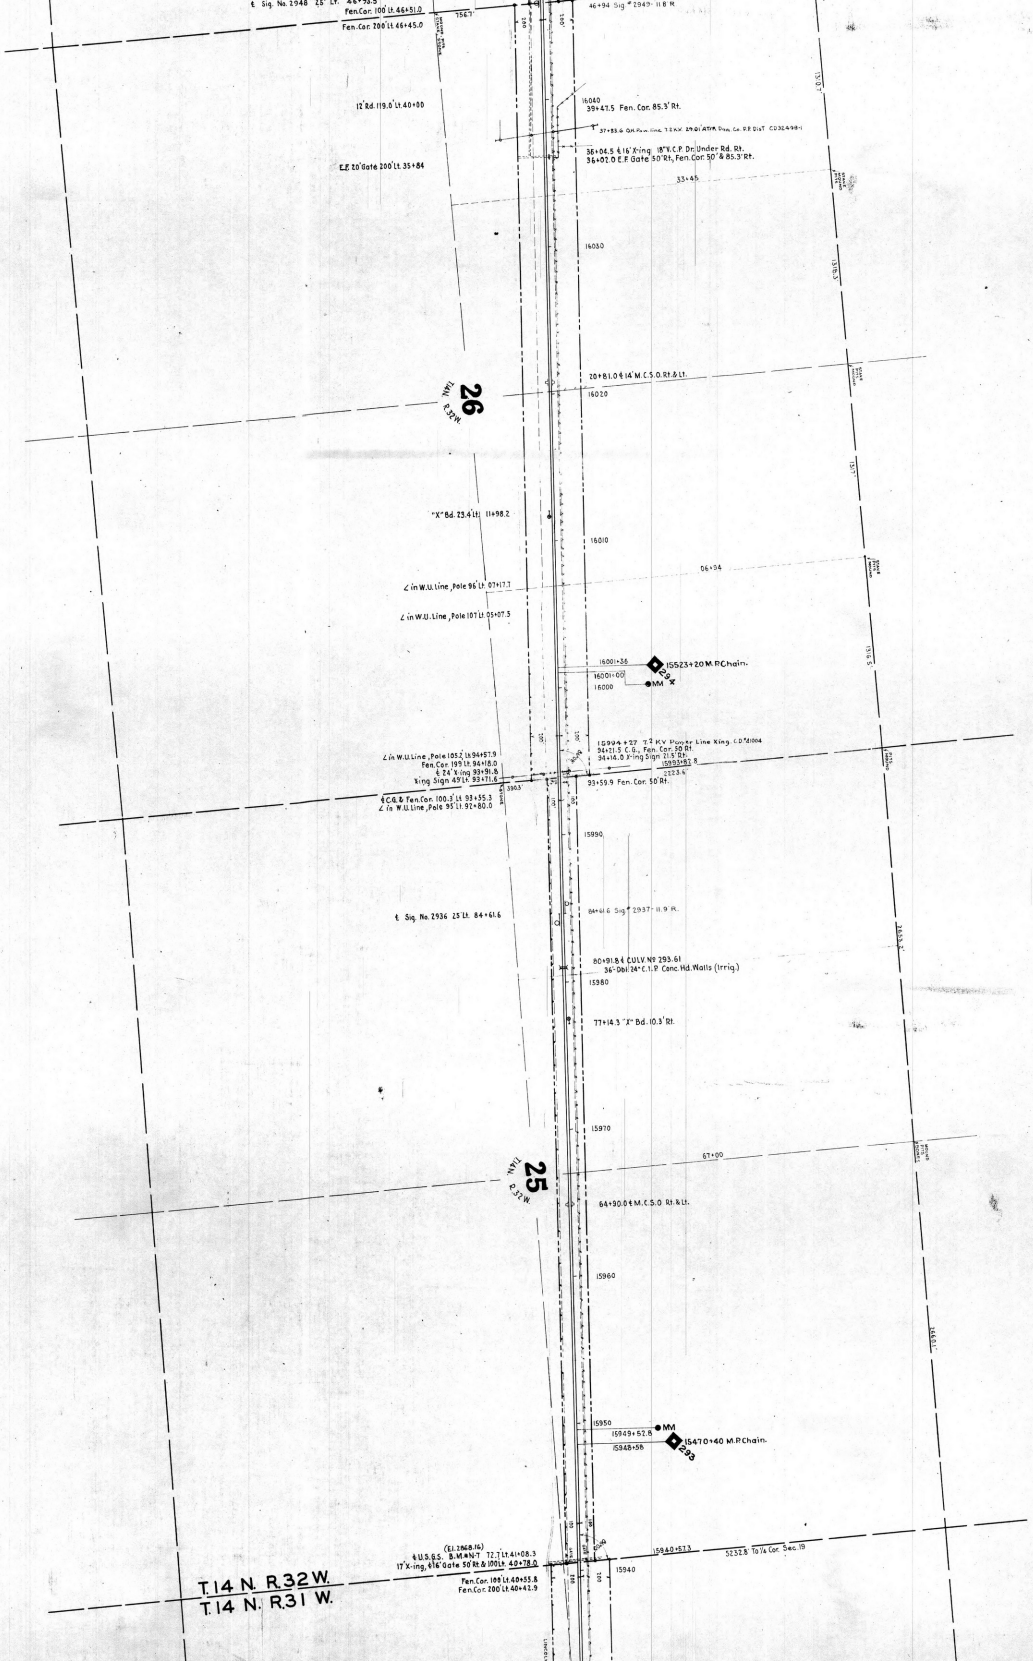

C.A. 6126
7/2/1937
Stanfield Irrig. District
Workman / Nagel

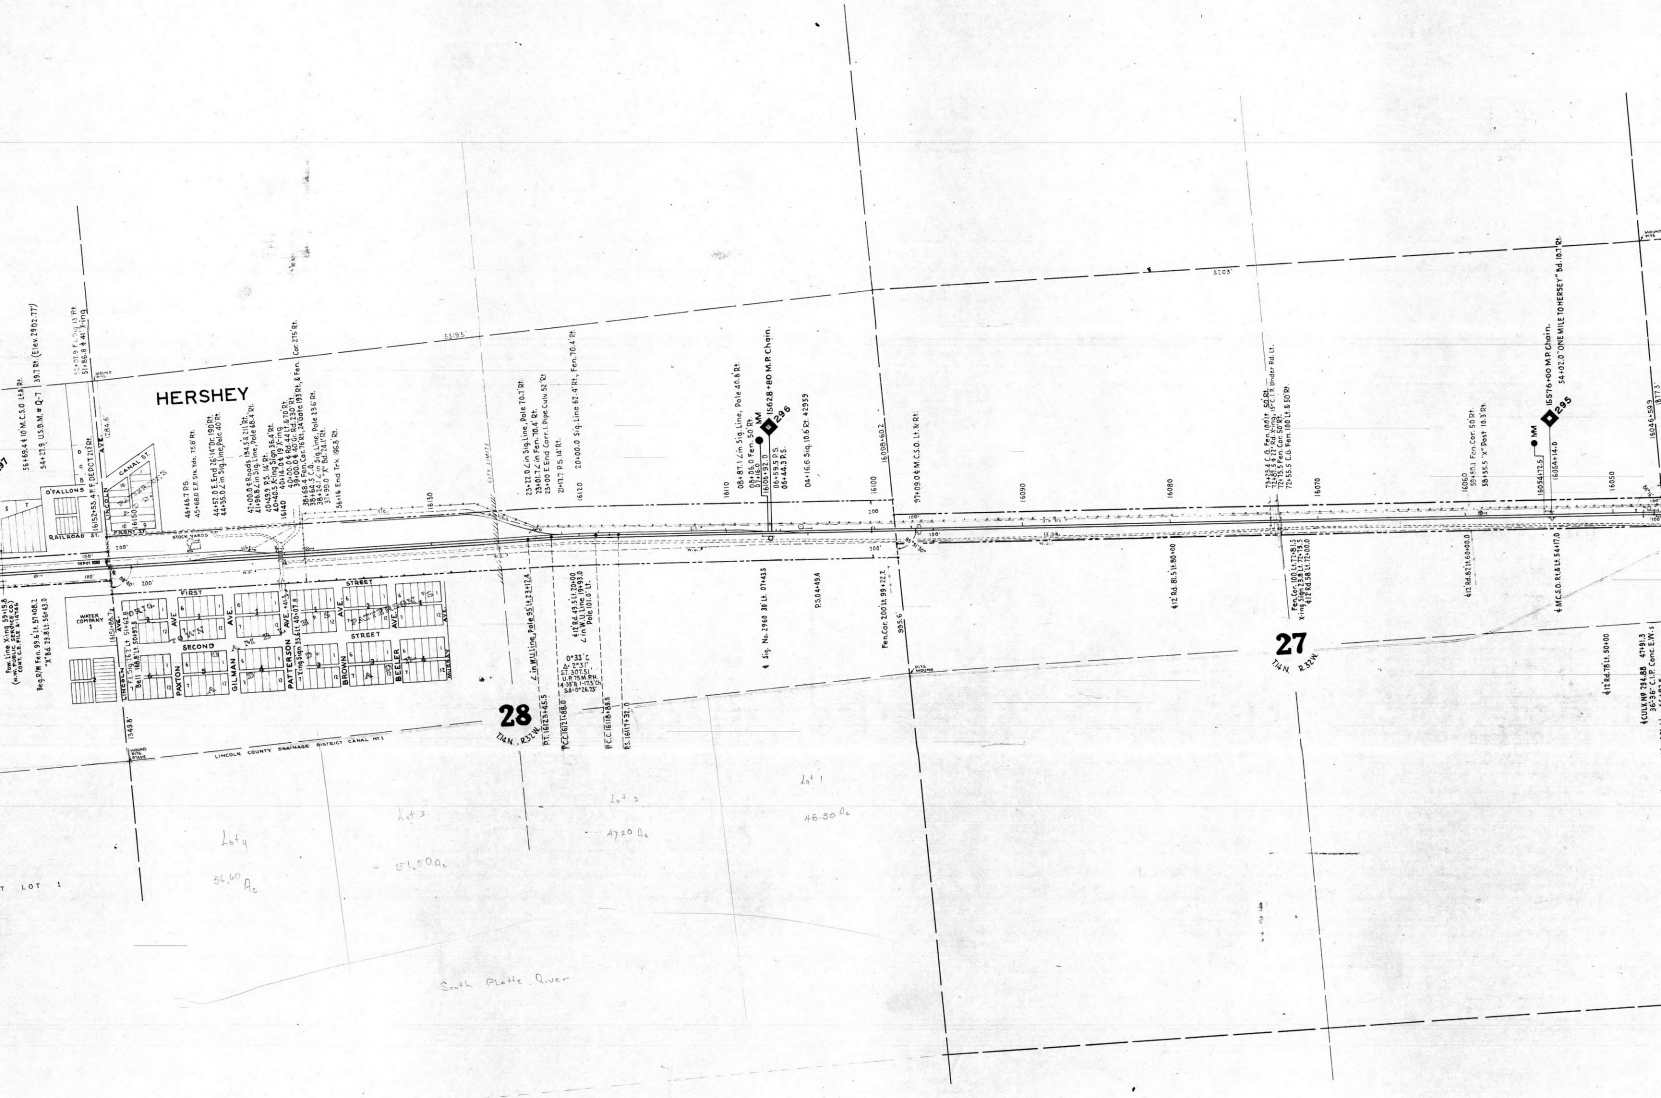
HERSHEY
O'FALLON
RAILROAD
CANAL ST
FRONT ST
VIRST
STREET
SECOND
STREET
PAXTON
GILMAN
PATTERSON
BROWN
BEELER
AVE
LINCOLN COUNTY DRAINAGE DISTRICT CANAL NO 1
28
South Platte River
Lot 1
46.50 Ac
Lot 3
47.20 Ac
Lot 4
56.60 Ac

"X" Bd. 25.5' Lt. 71+11.7

16270

16265+39.7 MM

15767+20 M.P. Chain.

229

16265+25.2

GOVT. LOT 4

57+72.4 R.E.A. 2 W. Pow. Line Poles 101' Lt. 8685'
57+67.8 ¢ Kol. C.G. Fen. 50' & 110' Rt., 100' Lt.
57+51.0 X-ing Sign 19.6' Rt.
57+44.5 4 18" Gd. X-ing

X-ing Sign 39' Lt. 87+31.0
F.E. 27'-18" V.C.P. 50' Lt. 57+30.0

16251+4.3

T. 14 N. R. 33 W.
T. 14 N. R. 32 W.

T.33 N.
R.33 W.

T.33 N.

57+29.7 E. End F.E. 36'-18" V.C.P. 23' Rt.
57+08.0 ¢ Kol. C.G. Fen. 50' Rt., 200' Lt.

16250

GOVT. LOT 2

45+87.5 "X" Bd. 10.5' Rt.

40+91.3 "O'FALLON 1 MILE" 10.5' Rt.

16240

GOVT. LOT 3

¢ 12' Rd. 41.5' Lt. 36+00

Pow. Line

16230

29+02.74 12" M.C.S.O. Rt. & Lt.

30

T.33 N.
R.33 W.

"ONE MILE TO HERSEY" Sign 25' Lt. 26+11.0

Sig # 2982. 24.7' Lt. - 24+508

24+51.4 Sig # 2983 12.0' Rt.

GOVT. LOT 4

16220

¢ 21' Gate 200' Lt. 18+49.5

17+40.3 Fen. Cor. 50' & 198.4' Rt., Ditch 120' Rt.

¢ 12' Rd. Lt. 34.5' Lt. 16+00

16212+77.0 MM

16212+47.5

15734+4.0 M.P. Chain.

229

16210

GOVT. LOT 5

¢ 17.5' Gate 200' Lt. 07+79.8

07+71.0 ¢ 17' Priv. Rd. X-ing
07+58.5 ¢ 16' Gate 200' Lt.

16204+34.7

1497.3
End Hog Tight Fen. & Fen. Cor. 100' Lt. 04+22.0
Fen. Cor. 200' Lt. 04+17.0

16200

GOVT. LOT 4

¢ 12' Rd. 65.5' Lt. 96+00

95+58.3 Fen. Cor. 50' & 99.8' Rt.

16190

¢ 12' Rd. 50' Lt. 85+00

85+82.4 CULV. NO 297.47
38'-30" C.L.P. Mas. Wall on Left
84+90.0 MC.O. Rt.

GOVT. LOT 3

16180

Begin Hog Tight Fe. 100' Lt. 78+27.5
¢ 15' Priv. Rd. X-ing 78+15.4
22' Gate Lt. & 16' Gate Rt.

29

T.33 N.
R.33 W.

GOVT. LOT 2

16170

68+13.0 C.G. Fen. Cor. 96.7' Rt. & Lt.

F.B.W. 68+44.0
RR. NO 297.16 F.B.W. 68+36.0
1-12" Sp. Trough Floor on Conc.
Handrail Both Sides
"X" Bd. 23.1' Lt. 66+97.5

62+87.3 W.S.

16153+86.8 MM

40+75.4 Sig. 10.5' Rt.
39+96.1 Sec. Marker 11.8' Rt. 185
194

16160

¢ Sig. No. 2970 25' Lt. 60+78.4

16159+69.9

15681+60 M.P. Chain.

GOVT.

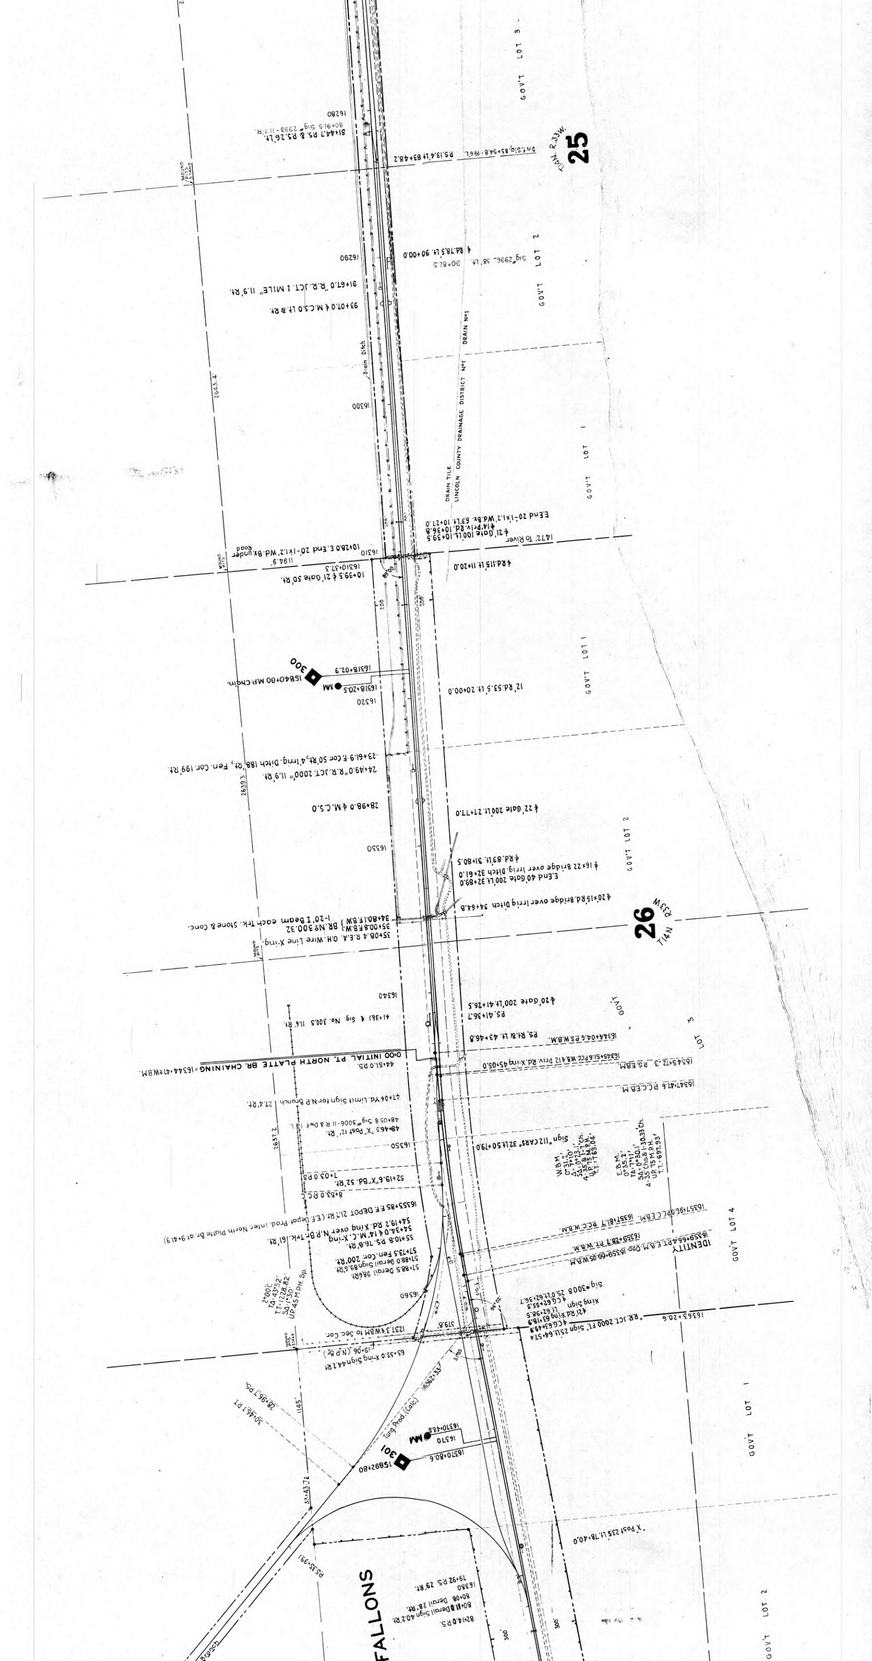

GOV'T LOT 3
25
GOV'T LOT 2
DRAIN No1
DRAIN TILE
LINCOLN COUNTY DRAINAGE DISTRICT No1
GOV'T LOT 1
GOV'T LOT 1
GOV'T LOT 2
26
0+00 INITIAL PT. NORTH PLATTE BR. CHAINING
IDENTITY
GOV'T LOT 4
GOV'T LOT 1
FALLONS
GOV'T LOT 2

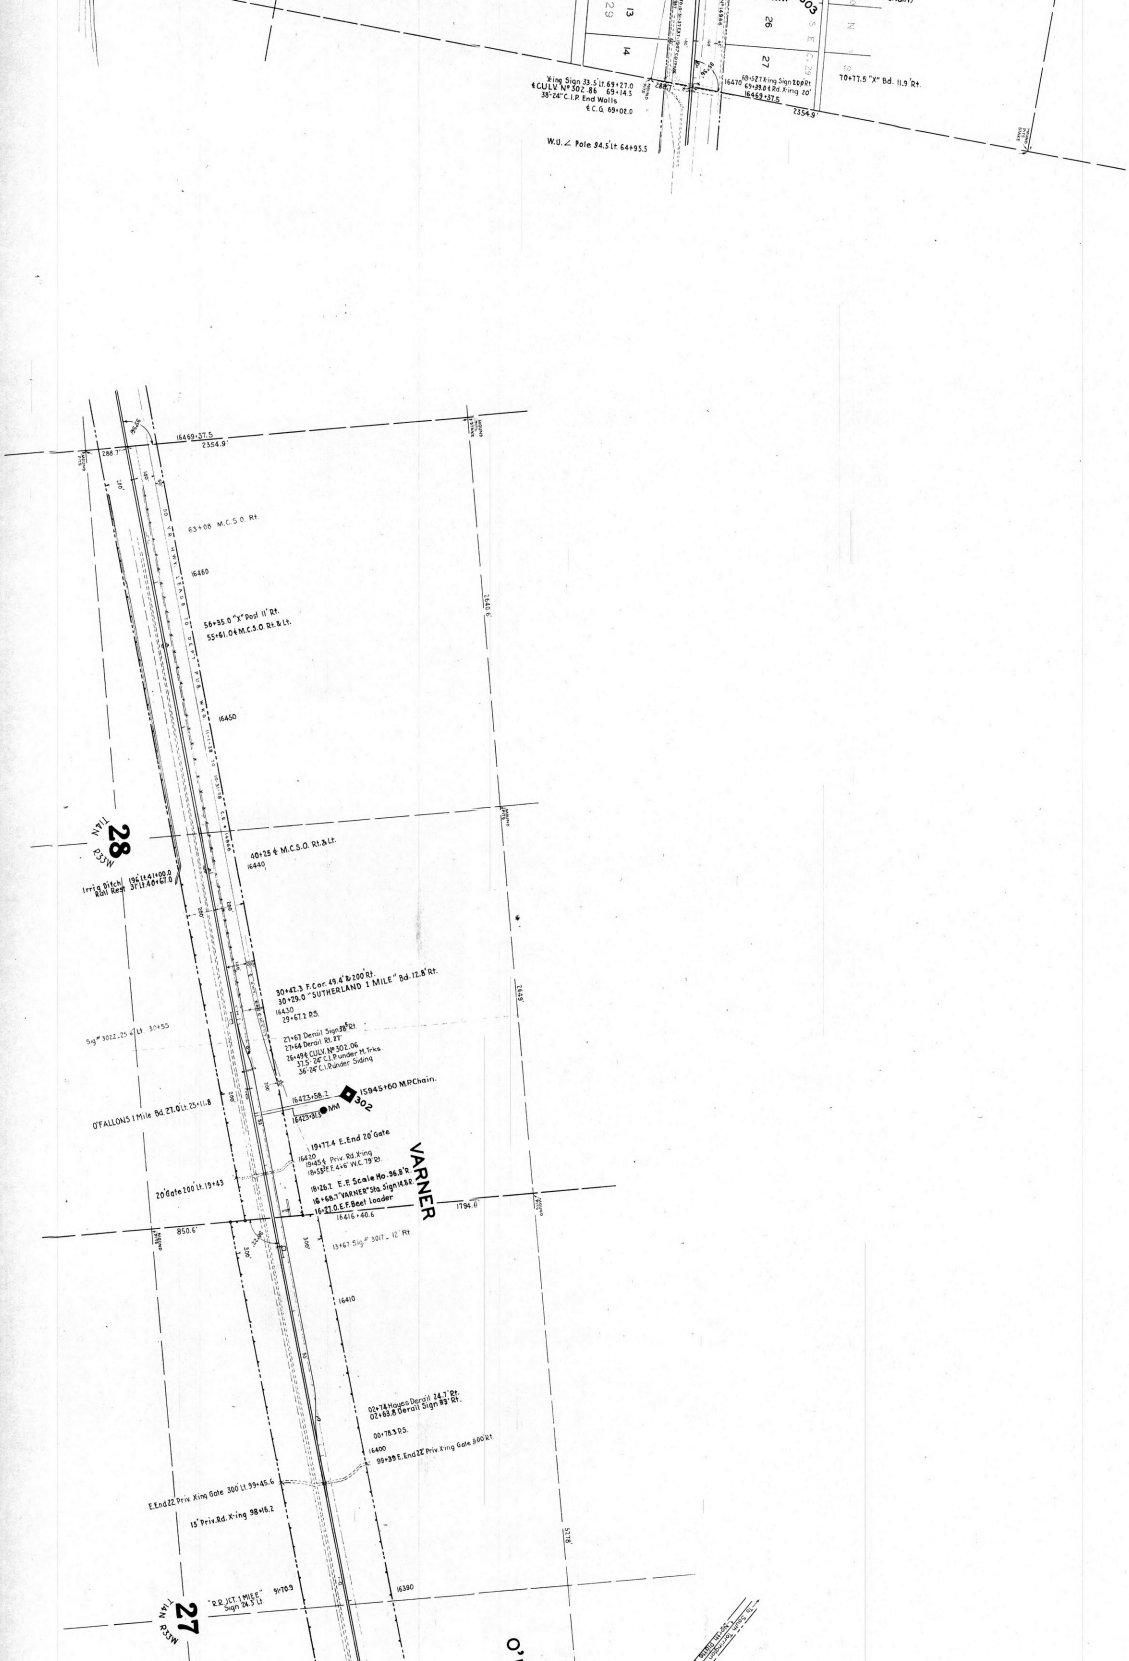

Xing Sign 33.5' Lt. 69+27.0
38'-24" C.I.P. End Walls
℄ C.G. 69+02.0
W.U. ∠ Pole 94.5' Lt. 64+95.5
68+52 T Xing Sign 20.0' Rt.
69+39.0 ℄ Rd. Xing 20'
16469+37.5
2354.9'
70+77.5 "X" Bd. 11.9' Rt.
16469+37.5
2354.9'
63+08 M.C.S.O. Rt.
16460
56+95.0 "X" Pool 11' Rt.
55+61.0 ℄ M.C.S.O. Rt. & Lt.
16450
40+25 ℄ M.C.S.O. Rt. & Lt.
16440
Irrig Ditch 196' Lt. 41+00.0
Rail Rest 37' Lt. 40+67.0
30+42.3 F. Cor. 49.4' & 200' Rt.
30+29.0 "SUTHERLAND 1 MILE" Bd. 12.8' Rt.
16430
29+67.2 P.S.
Sig# 3022 - 25.4' Lt. 30+55
27+67 Derail Sign 28.8' Rt.
27+64 Derail Rt. 27'
37.5'-26" C.I.P. under M. Trks.
36'-24" C.I.P. under Siding
15945+60 M.P. Chain.
302
16423+58.2
16423+58.2
O'FALLONS 1 Mile Bd. 27.0' Lt. 25+11.8
19+77.4 E. End 20' Gate
16420
19+85 ℄ Priv. Rd. X'ing
18+55 E.E. 4+6" W.C. 79' Rt.
18+26.2 E.F. Scale No. 96.8' R.
16+68.7 "VARNER" Sta. Sign 14.8' R.
16+27.0 E.F. Beet Loader
16416+40.6
VARNER
20' Gate 200' Lt. 19+43
850.6'
1794.0'
13+67 Sig# 3017 - 12' Rt.
16410
02+74 Hayes Derail 24.7' Rt.
02+63.8 Derail Sign 93' Rt.
00+78.3 P.S.
16400
99+99 E. End 22' Priv. X'ing Gate 800' Rt.
E. End 22 Priv. X'ing Gate 300' Lt. 99+45.6
15' Priv. Rd. X'ing 98+16.2
"R.R. JCT. 1 MILE" Sign 24.3' Lt.
91+70.9
16390
28
T14N
R33W
27
T14N
R33W

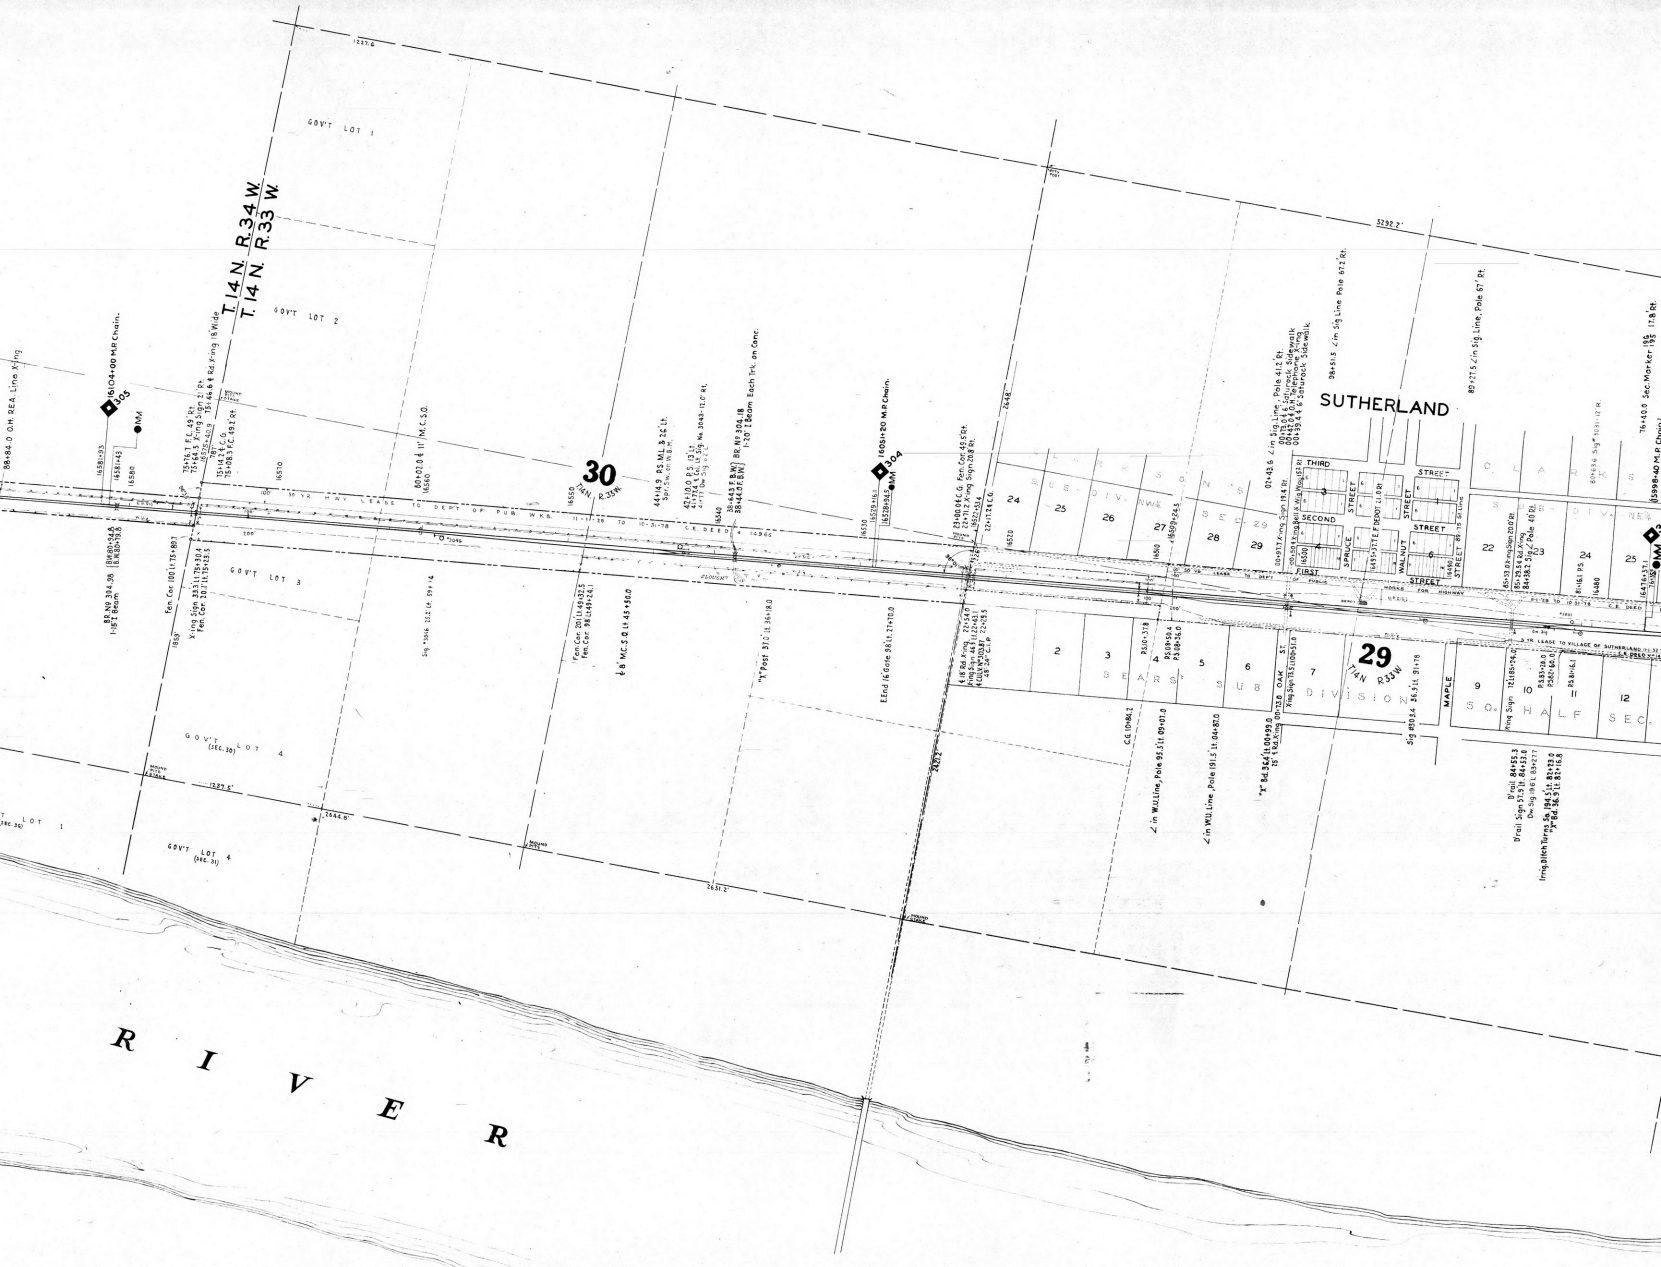

T. 14 N. R. 34 W.
T. 14 N. R. 33 W.
GOV'T LOT 1
GOV'T LOT 2
GOV'T LOT 3
GOV'T LOT 4
30
29
SUTHERLAND
THIRD STREET
SECOND STREET
FIRST STREET
SPRUCE STREET
WALNUT STREET
MAPLE
OAK ST.
SEARS SUB DIVISION
SO. HALF SEC.
RIVER

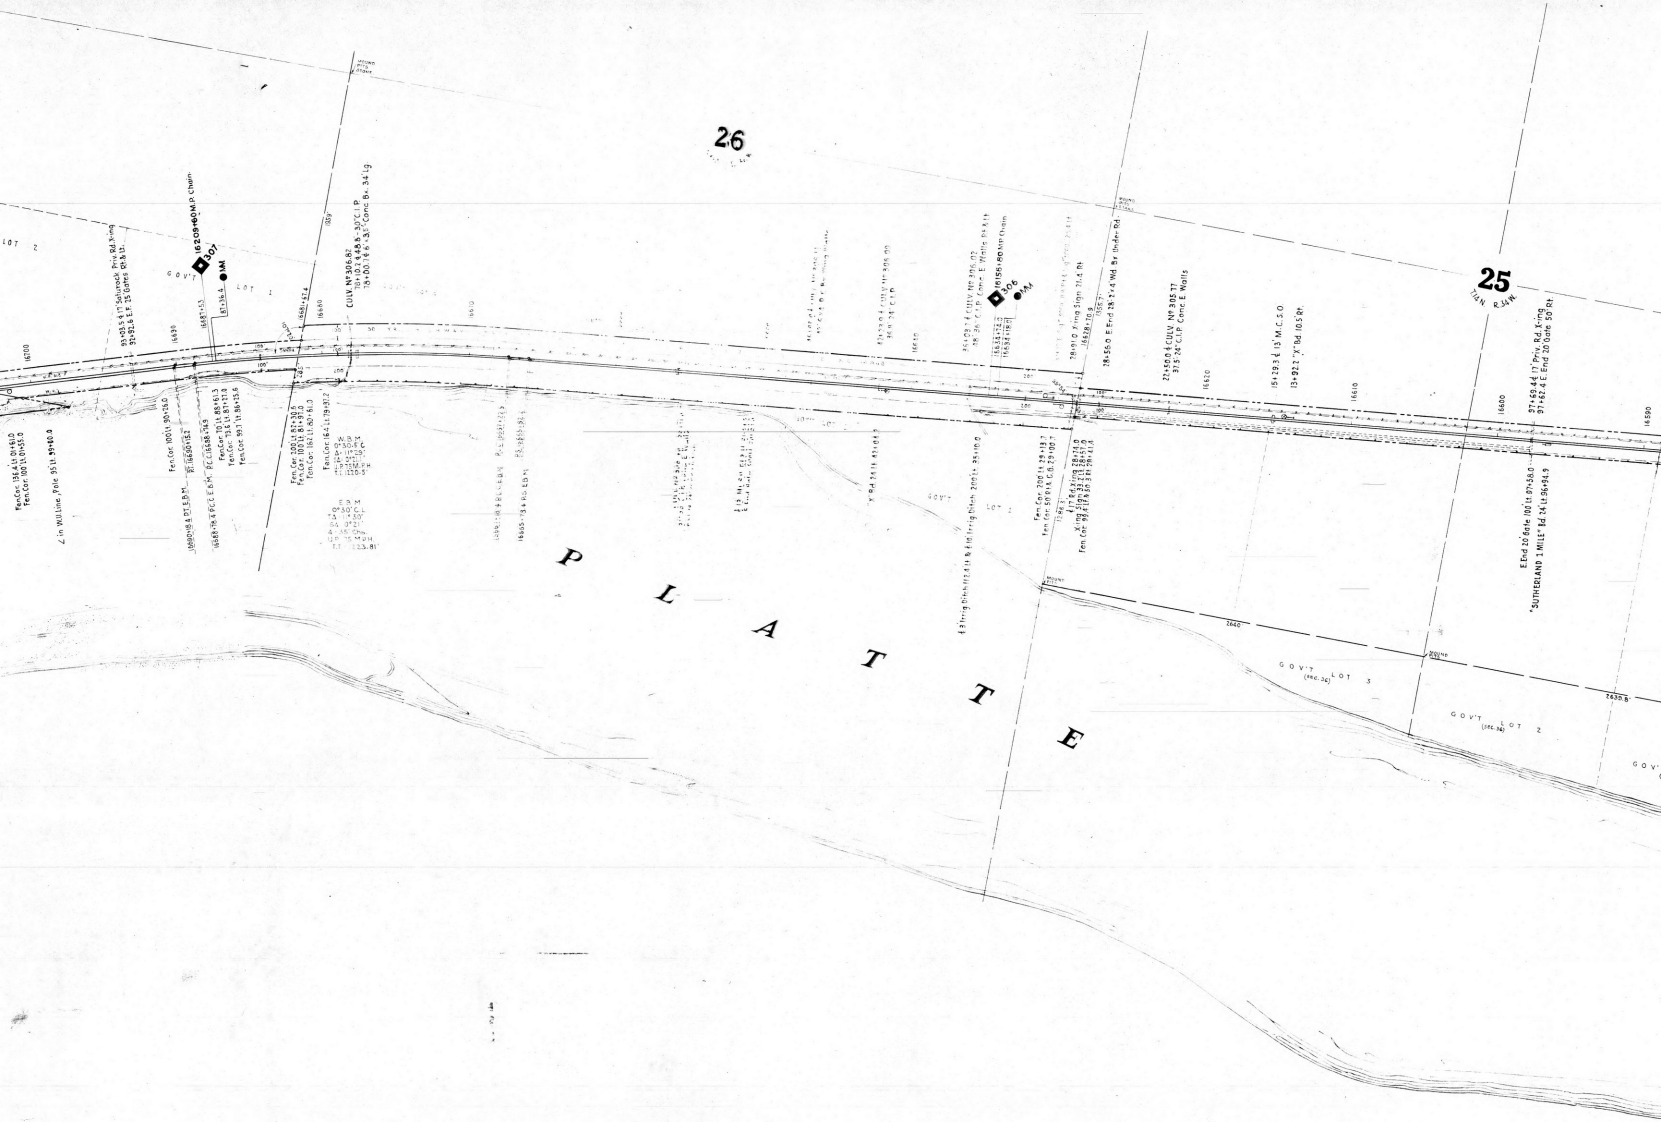
26
25
T 14 N R 34 W
P L A T T E
GOV'T LOT 3
GOV'T LOT 2
16620
16610
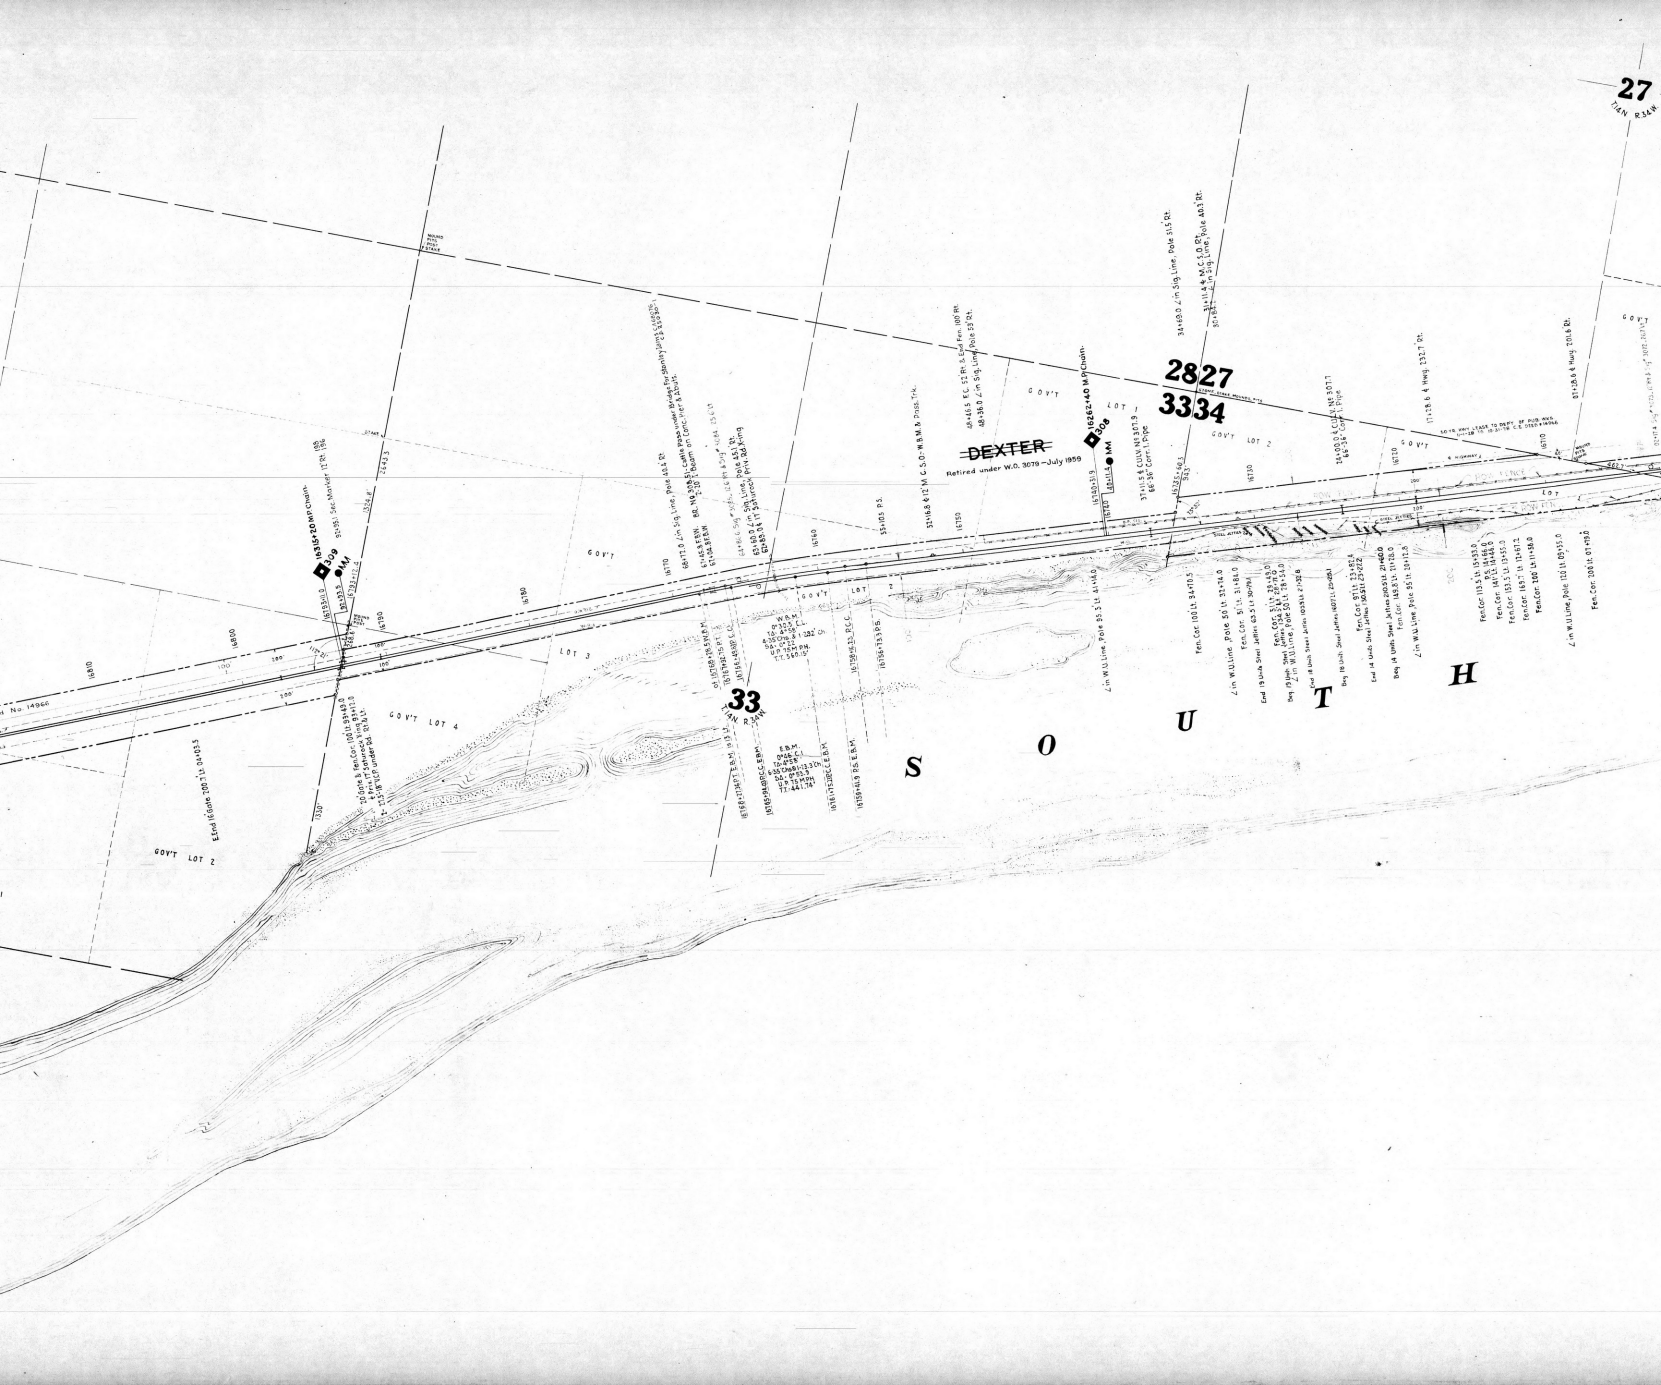
27
T14N R34W
28
27
33
34
DEXTER
Retired under W.O. 3079 – July 1959
33
T14N R34W
S O U T H
GOV'T LOT 2
GOV'T LOT 3
GOV'T LOT 4
GOV'T LOT 1
LOT 2
LOT 3
LOT 4
LOT 1

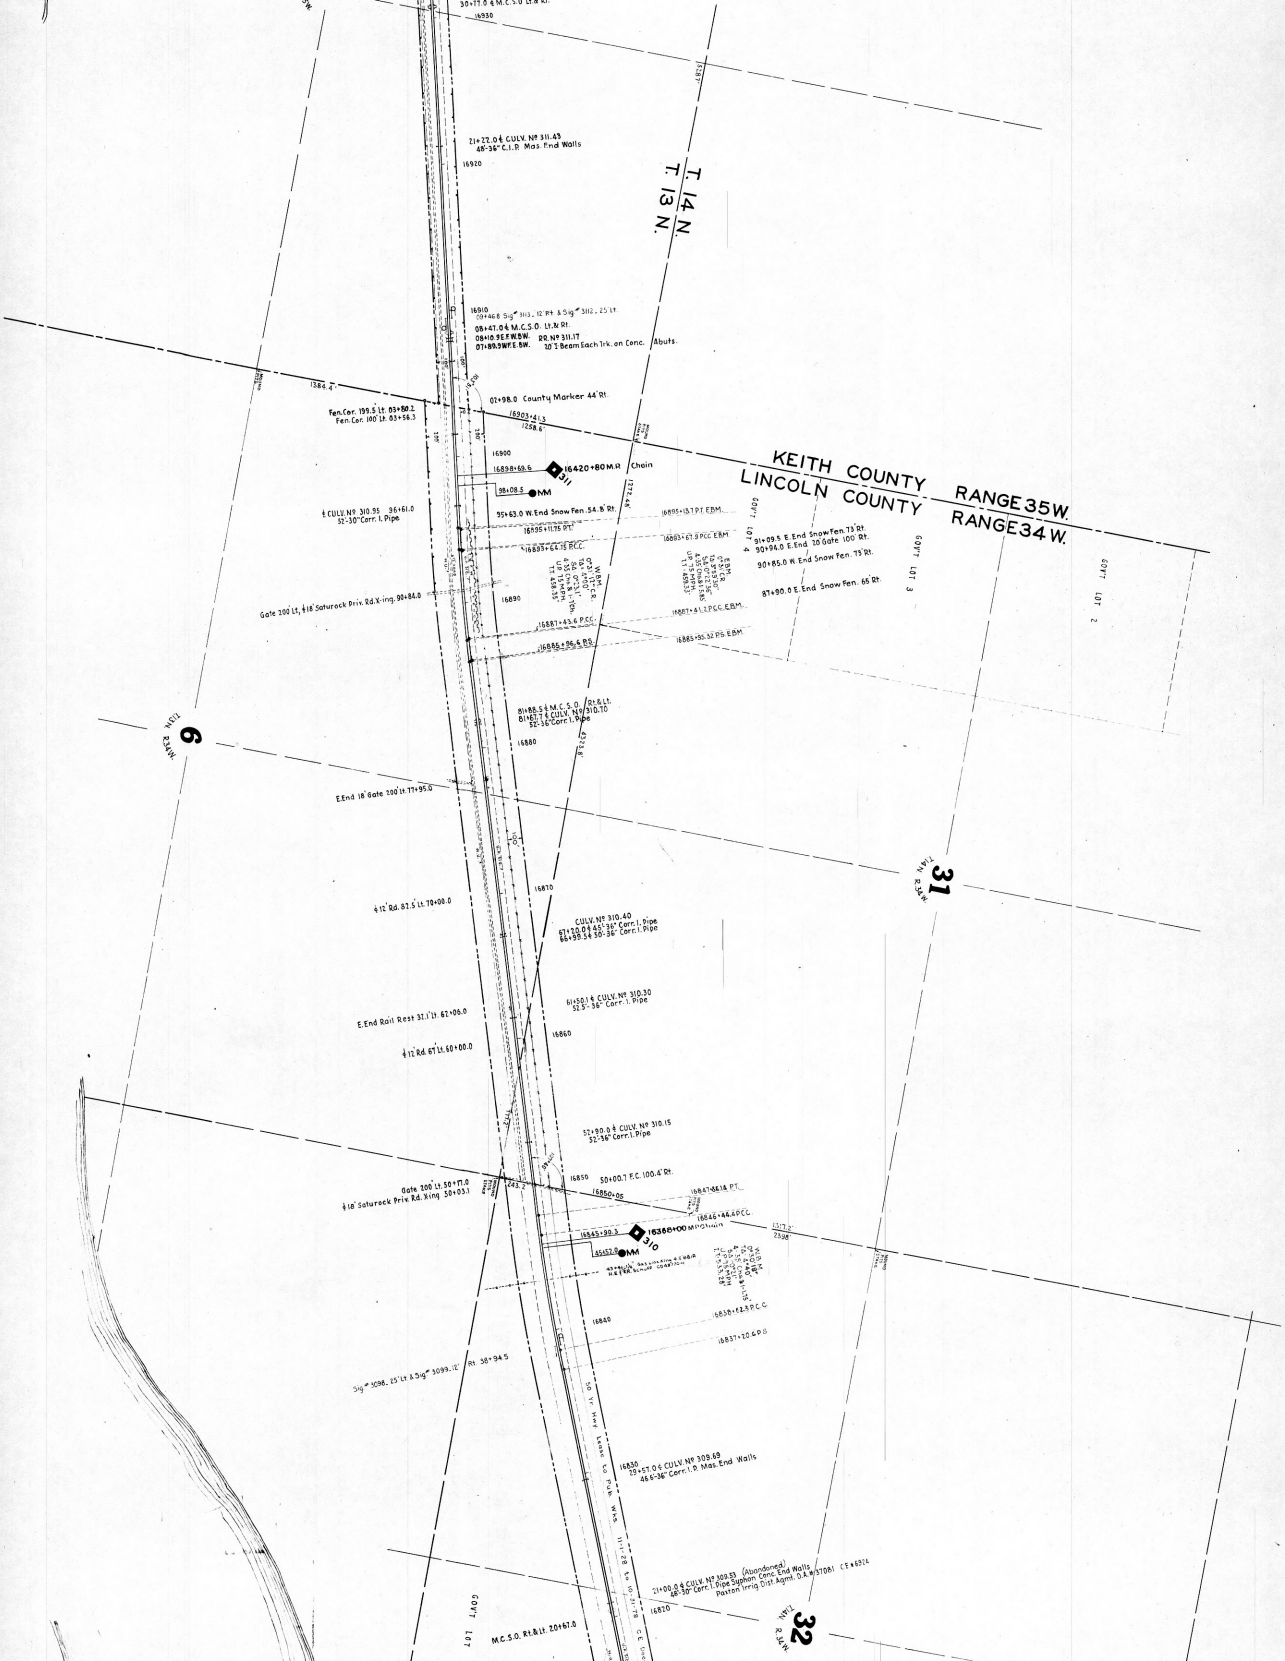
KEITH COUNTY RANGE 35 W.
LINCOLN COUNTY RANGE 34 W.
T. 14 N.
T. 13 N.
31
32
6
GOVT. LOT 2
GOVT. LOT 3
GOVT. LOT 4
GOVT. LOT 1
16930
16920
16910
16900
16890
16880
16870
16860
16850
16840
16830
16820
21+22.0 ℄ CULV. Nº 311.43
26-36" C.I.P. Mas. End Walls
08+47.0 ℄ M.C.S.O. Lt. & Rt.
08+10.9 E.F. WEBW.
07+99.3 W.F.E. BW.
10' Beam Each Trk. on Conc. Abuts.
07+98.0 County Marker 44' Rt.
Fen. Cor. 199.5' Lt. 05+80.2
Fen. Cor. 100' Lt. 05+56.3
16420+80 M.R. Chain
98+08.5
95+63.0 W. End Snow Fen. 54.8' Rt.
16895+13.7 P.T. E.B.M.
16895+11.76 P.T.
16893+67.9 P.C.C. E.B.M.
16893+64.3 P.C.C.
90+09.5 E. End Snow Fen. 73' Rt.
90+94.0 E. End 10' Gate 100' Rt.
90+85.0 W. End Snow Fen. 75' Rt.
87+90.0 E. End Snow Fen. 65' Rt.
16887+61.2 P.C.C. E.B.M.
16887+43.6 P.C.C.
16885+35.32 P.S. E.B.M.
16886+96.6 P.S.
℄ CULV. Nº 310.95 96+61.0
52-30" Corr. I. Pipe
Gate 200' Lt. & 18' Saturock Priv. Rd. X-ing. 99+84.0
81+88.5 ℄ M.C.S.O. Rt. & Lt.
81+67.7 ℄ CULV. Nº 310.10
52-36" Corr. I. Pipe
E. End 18' Gate 200' Lt. 77+95.0
℄ 12' Rd. 87.5' Lt. 70+00.0
CULV. Nº 310.40
87+30.0 ℄ 45-36" Corr. I. Pipe
86+99.34 50-36" Corr. I. Pipe
61+50.1 ℄ CULV. Nº 310.30
52-36" Corr. I. Pipe
E. End Rail Rest 31.1' Lt. 62+06.0
℄ 12' Rd. 67' Lt. 60+00.0
57+90.0 ℄ CULV. Nº 310.15
52-36" Corr. I. Pipe
Gate 200' Lt. 50+77.0
℄ 18' Saturock Priv. Rd. X-ing 50+05.3
50+00.7 E.C. 100.4' Rt.
16847+66.14 P.T.
16846+46.4 P.C.C.
16845+90.3
16538+00 M.R. Chain
16552.0
16838+62.3 P.C.C.
16837+70.6 P.S.
Sig. Nº 3096.25' Lt. & Sig. Nº 3099.12' Rt. 38+94.5
50' R/W Have Least 50' Pub. W.B. 11+12.28 to 10+12.78 C.E. Inv.
16830
29+57.0 ℄ CULV. Nº 309.69
46-36" Corr. I. P. Mas. End Walls
21+00.0 ℄ CULV. Nº 309.53 (Abandoned)
48-30" Corr. I. Pipe Siphon Conc. End Walls
Paxton Irrig. Dist. Agmt. D.A. #3708 C.E. #6924
M.C.S.O. Rt. & Lt. 20+67.0
T. 14 N. R. 34 W.
T. 14 N. R. 35 W.

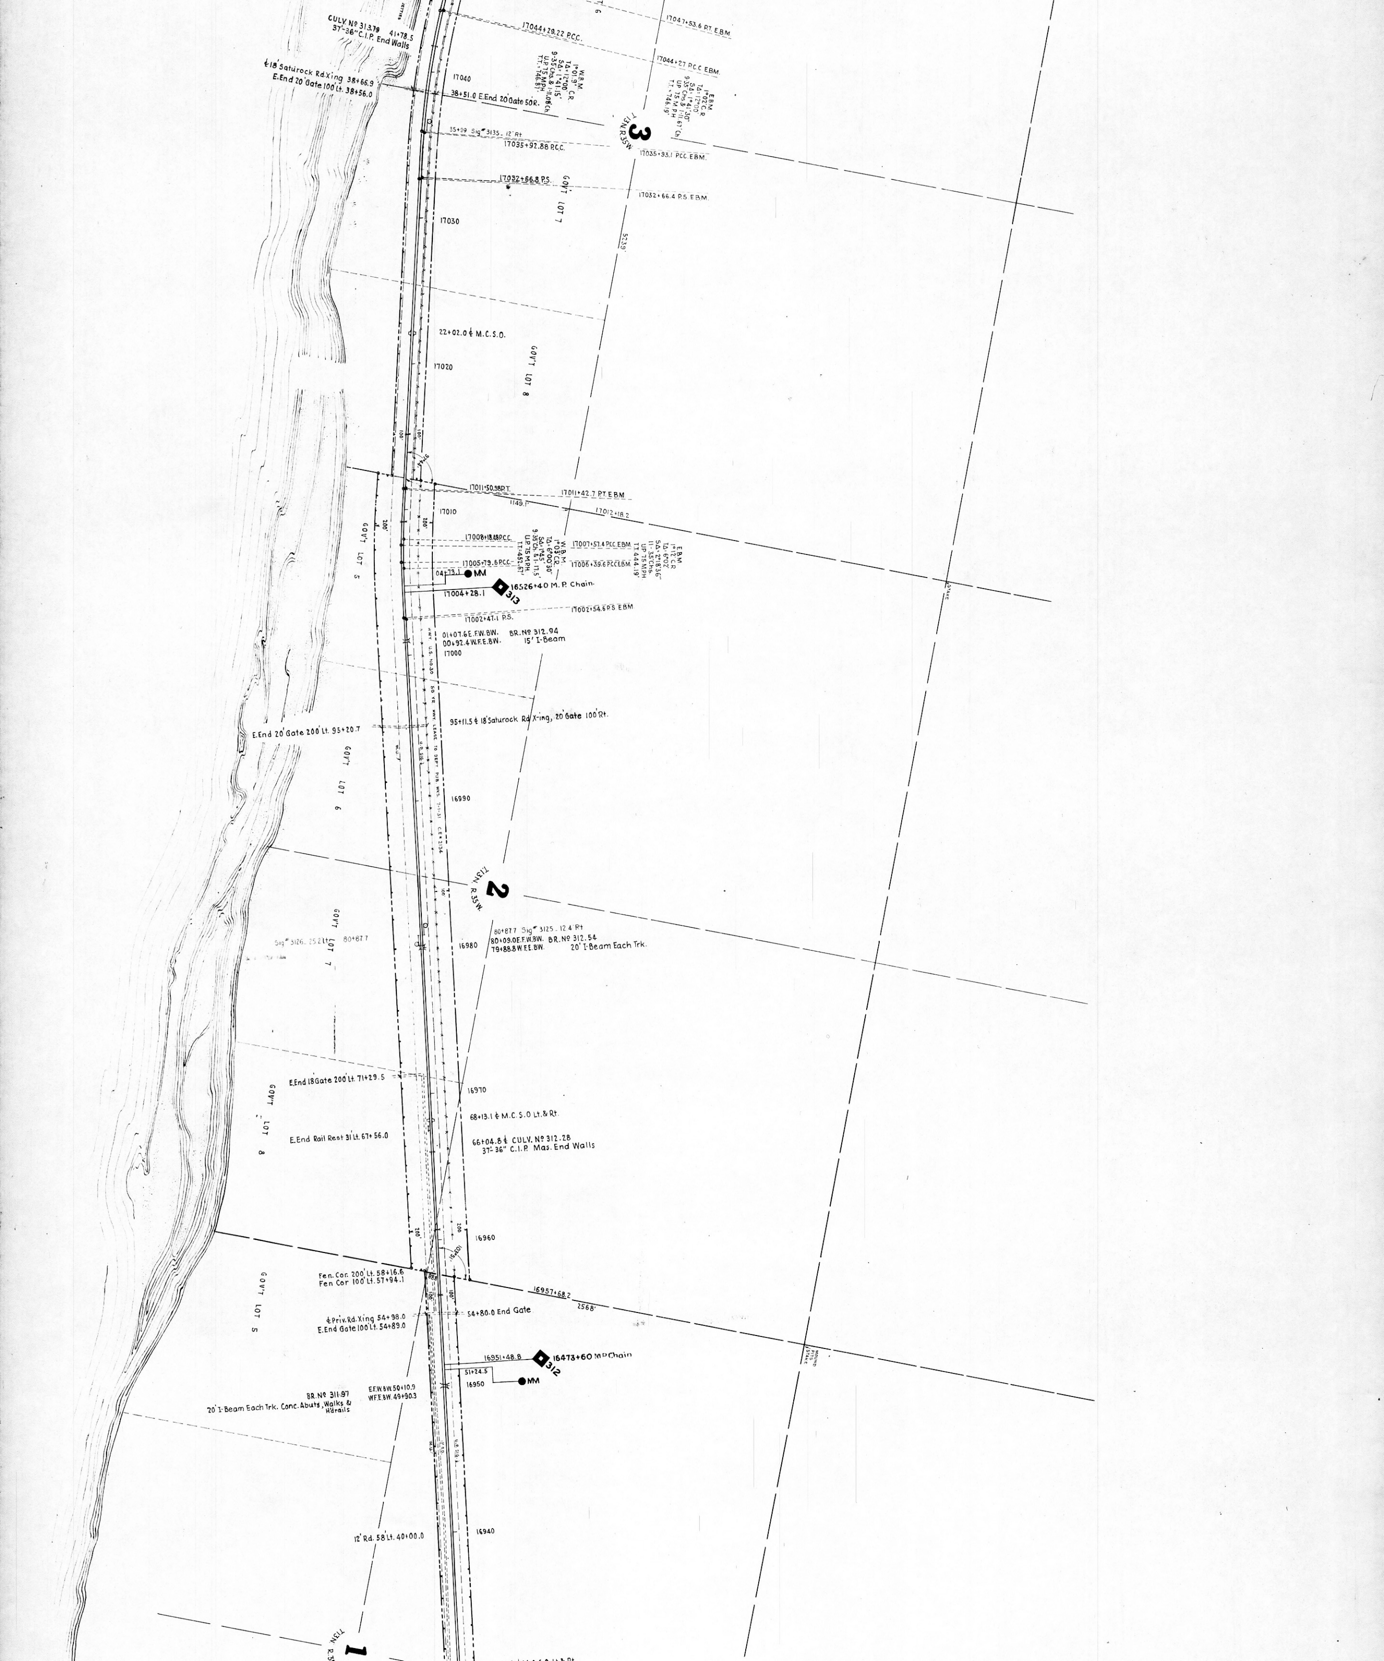

CULV. Nº 313.79 41+78.5
37-36" C.I.P. End Walls
℄ 18' Saturock Rd. X-ing 38+66.9
E. End 20' Gate 100' Lt. 38+56.0
38+51.0 E. End 20' Gate 50' R.
17040
17044+29.22 P.C.C.
17044+27 P.C.C. E.B.M.
17047+53.6 P.T. E.B.M.
3
T13N. R.35W.
35+09 Sig. 3135 12' Rt.
17035+92.88 P.C.C.
17035+93.1 P.C.C. E.B.M.
17032+66.8 P.S.
17032+66.4 P.S. E.B.M.
GOV'T LOT 7
17030
5239'
22+02.0 ℄ M.C.S.O.
17020
GOV'T LOT 8
17011+50.38 P.T.
17011+42.7 P.T. E.B.M.
17012+18.2
17010
17008+18.18 P.C.C.
17007+57.4 P.C.C. E.B.M.
17006+39.6 P.C.C. E.B.M.
17005+79.6 P.C.C.
16526+40 M.P. Chain
313
17004+28.1
17002+41.1 P.S.
17002+54.6 P.S. E.B.M.
GOV'T LOT 5
01+07.6 E.F.W.B.W.
00+92.4 W.F.E.B.W.
BR. Nº 312.94
15' I-Beam
17000
95+11.5 ℄ 18' Saturock Rd. X-ing, 20' Gate 100' Rt.
E. End 20' Gate 200' Lt. 95+20.7
GOV'T LOT 6
16990
2
T13N. R.35W.
80+87.7 Sig. 3125 12.4 Rt.
80+09.0 E.F.W.B.W.
79+88.8 W.F.E.B.W.
BR. Nº 312.54
20' I-Beam Each Trk.
16980
GOV'T LOT 7
E. End 18' Gate 200' Lt. 71+29.5
16970
68+13.1 ℄ M.C.S.O. Lt. & Rt.
66+04.8 ℄ CULV. Nº 312.28
37-36" C.I.P. Mas. End Walls
GOV'T LOT 8
E. End Rail Rest 31' Lt. 67+56.0
16960
Fen. Cor. 200' Lt. 58+16.6
Fen. Cor. 100' Lt. 57+94.1
16957+68.2
2568'
54+80.0 End Gate
℄ Priv. Rd. X-ing 54+98.0
E. End Gate 100' Lt. 54+89.0
GOV'T LOT 5
16951+48.8
16473+60 M.P. Chain
312
51+24.5
16950
MM
BR. Nº 311.97
20' I-Beam Each Trk. Conc. Abuts, Walks & H'drails
E.F.W.B.W. 50+10.9
W.F.E.B.W. 49+90.3
16940
12' Rd. 58' Lt. 40+00.0
1

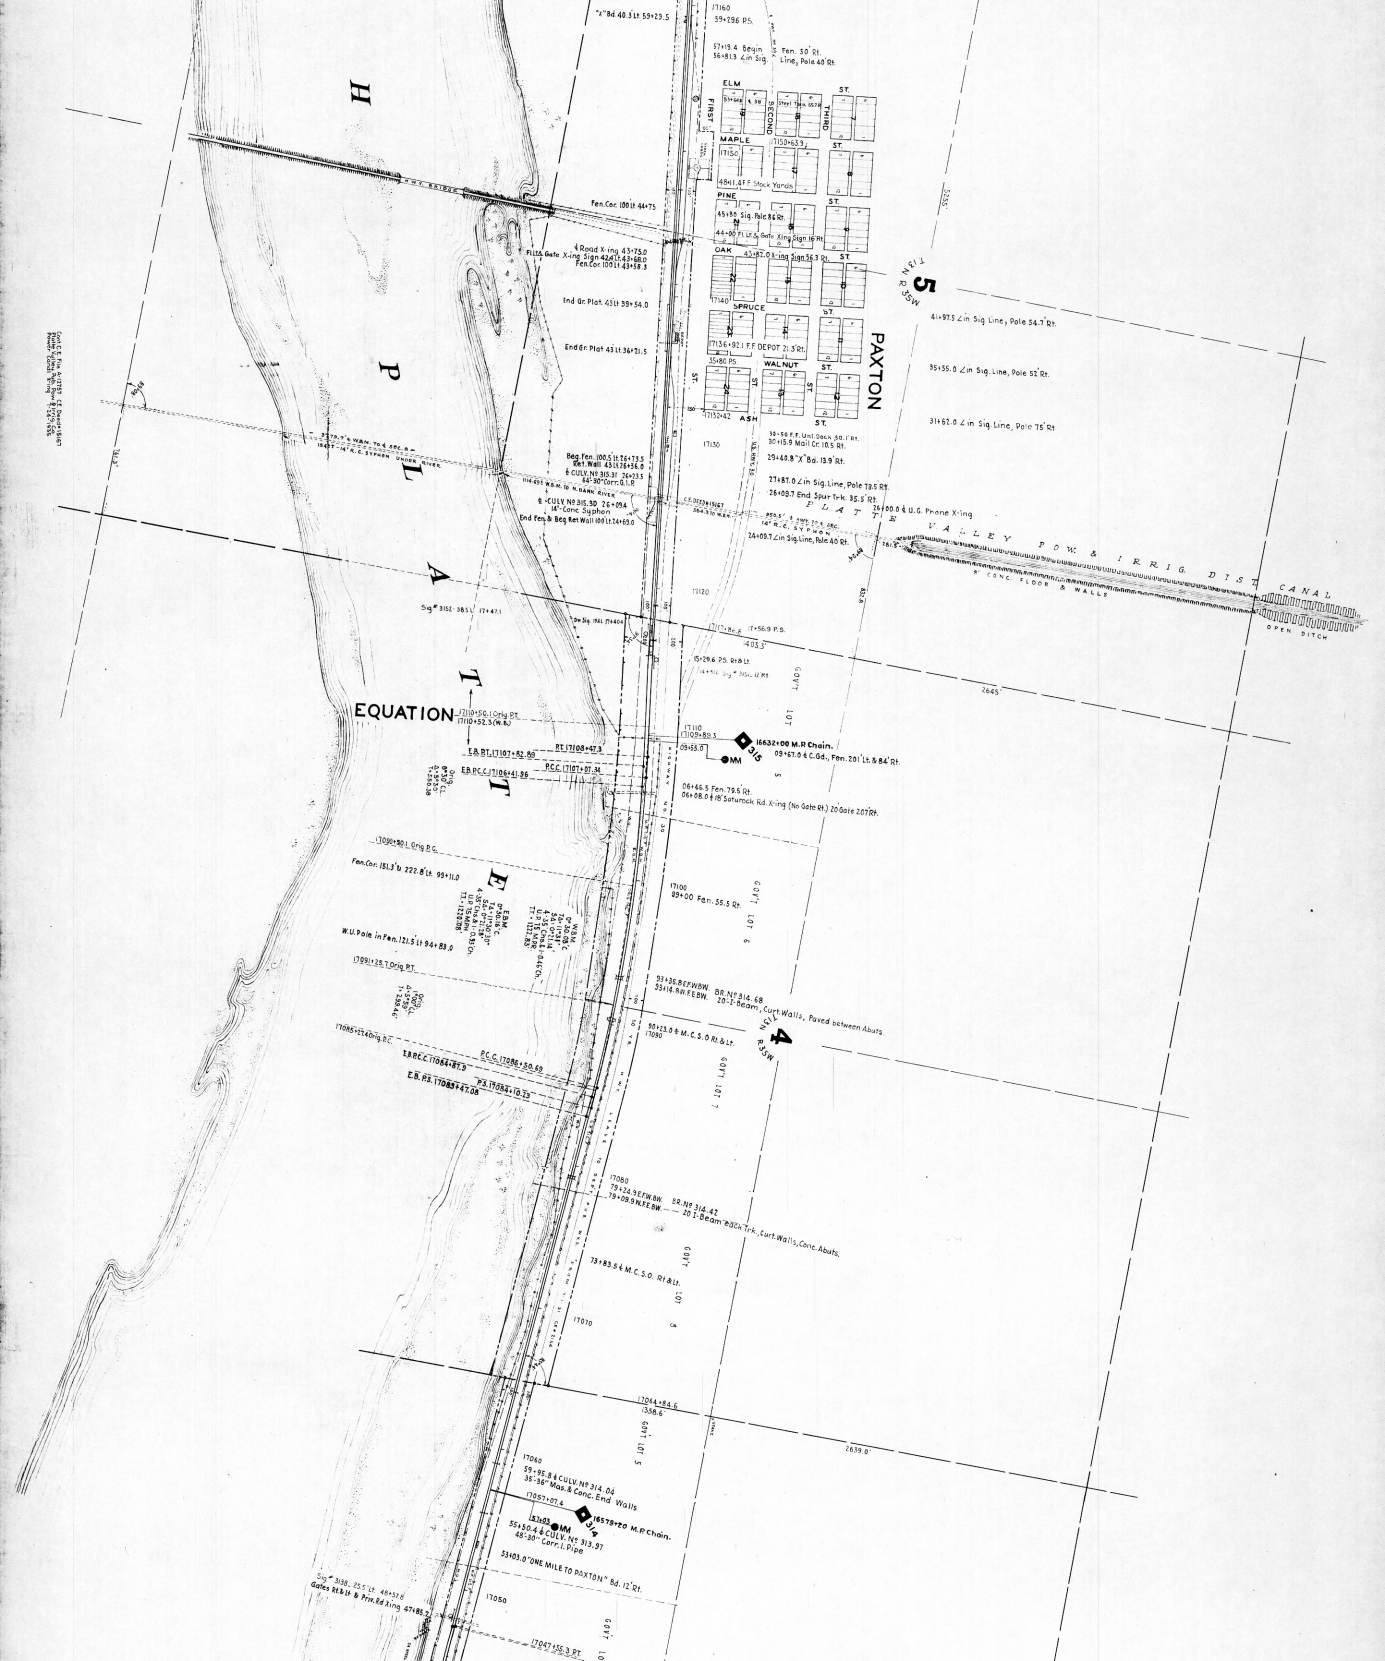

PAXTON
EQUATION
PLATTE
PLATTE VALLEY POW. & IRRIG. DIST. CANAL
OPEN DITCH
ELM
MAPLE
PINE
OAK
SPRUCE
WALNUT
ASH
FIRST
SECOND
THIRD
ST.
5
4
16632+00 M.P. Chain.
16579+20 M.P. Chain.

UNION PACIFIC RAILROAD

NEBRASKA DIVISION — MAIN LINE

NORTH PLATTE TO PAXTON

KEITH & LINCOLN COUNTIES, NEBRASKA

M. P. 281.94 to M. P. 316.61

Station 17365 + 00 to Station 17195 + 00

SECTION 35. T. 14 N. R. 30 W. to SECTION 5. T. 13 N. R. 35 W.

Scale 1" = 400'

Office of Chief Engineer, U.P.R.R., Omaha, Nebr., Jan. 6, 1950

Plotted from former maps C. E. Dwg. No. 13878 & 13742. "As Constructed" Work Order prints to date. Letter of 3-30-46 C. E. File A-10620. & Resurvey of 1948-1949 Nebr. Div. Notebooks No. 1847, 1848, 1861, 1866, 1869 & 1870.

PLOTTED BY	TRACED BY	CHECKED BY
IMS	IMS	JEV

CHECKED AS TO RIGHT OF WAY BY R.L.F. DATE 4-26-50

C. E. DRAWING NO. 80232

Corrected to