FED. ROAD DIV. NO.	STATE	FED. AID PROJ. NO.	FISCAL YEAR	SHEET NO.
-5	NEB.	S-379(4)		1

REV. 10-15-59

(6)

INDEX OF SHEETS

SHEET NO. 1. TITLE PAGE.
" " 2. TYPICAL CROSS-SECTION OF IMPROVEMENT NO. 2-S 379(4)$_1$, 2-S 379(4)$_2$ & 2-G-R3

" " 2-K Details of Location Sketch

" " 2-S$_1$ Summary of Quantities
" " 2-S$_2$ " " "

" " 2-L$_1$ Details of Construction
" " 2-L$_2$ " " "
" " 2-L$_3$ " " "
" " 2-L$_4$ " " "
" " 2-L$_5$ " " "

" " 3. Plan and Profile Sta. 174 +35.9 to Sta. 180 +00
" " 4. " " " " 180 +00 " " 210 +00
" " 5. " " " " 210 +00 " " 240 +00
" " 6. " " " " 240 +00 " " 270 +00
" " 7. " " " " 270 +00 " " 300 +00
" " 8. " " " " 300 +00 " " 330 +00
" " 9. " " " " 330 +00 " " 360 +00
" " 10. " " " " 360 +00 " " 390 +00
" " 11. " " " " 390 +00 " " 420 +00
" " 12. " " " " 420 +00 " " 450 +00
" " 13. " " " " 450 +00 " " 473 +90

" " 14. to 23. Computations and Slopes, take Data.

" " 24. to ~~37~~ 38 Cross Sections
" " ~~38~~ to ~~41~~ 39 42 Cross Sections at Culvert Sites

" " ~~42~~ 43 Details of Construction Plan S 379(4)-1C (2 Sheets)
" " ~~43~~ 44 " " " " 414-J-R4 (2 Sheets)
" " ~~44~~ 45 " " " " 414-N2
" " ~~45~~ 46 " " " " 1699-R2
" " ~~46~~ 47 " " " " 1718-A
" " ~~47~~ 48 " " " " 1816-A-R1
" " ~~48~~ 49 " " " " 1844-A-R1

STATE OF NEBRASKA
DEPARTMENT OF ROADS
BUREAU OF HIGHWAYS
PLAN AND PROFILE OF PROPOSED
STATE HIGHWAY
FEDERAL AID SECONDARY PROJECT
STELLA EAST
RICHARDSON COUNTY

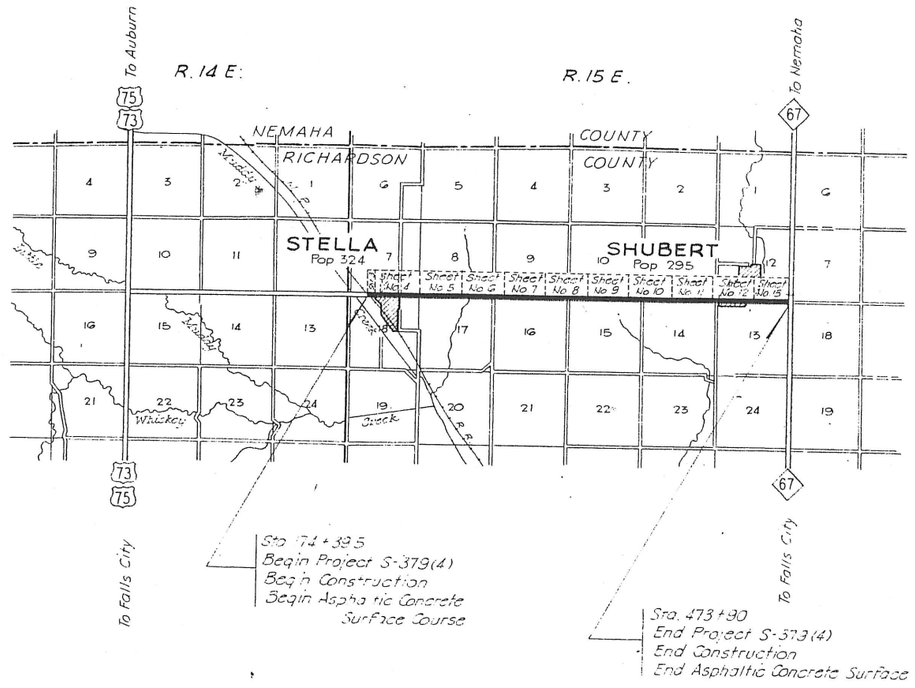

N

RIGHT OF WAY DIVISION

-LEGEND-

New R.O.W. - Non-Controlled Access
New R.O.W. - Controlled Access
Previous R.O.W.
Channel
Dike
Access Road
R.R. Easement
Fill Encroachment

Drawn-Jan-1960

CONVENTIONAL SIGNS

STATE LINE
COUNTY LINE
CITY or VILLAGE LIMITS
SECTION LINE
FENCE LINE
GUARD RAIL
RAILROADS
RIGHT-OF-WAY LINE
R.O.W. & CONTROLLED ACCESS LINE
CONTROLLED ACCESS LINE
TRAVELED WAY

BASE or SURVEY LINE
DYKE
CULVERTS
POWER POLE
TELEPHONE or TELEGRAPH POLE
MARSH
HEDGE
TREES
GROUND ELEVATION
GRADE ELEVATION

EQUATION

EXCEPTIONS

FROM STA.	TO STA.	INCLUDED IN THIS LAYOUT

TOTAL LENGTH OF EXCEPTIONS FEET
TOTAL NET LENGTH OF Proj S-379(4) 29,950.5 FEET 5.672 MILES

APPROVED 5/17 1959

J. C. Frost
DESIGN ENGINEER

A. C. Cochran
STATE ENGINEER

DEPARTMENT OF COMMERCE
BUREAU OF PUBLIC ROADS

APPROVED

DIVISION ENGINEER DATE

DUIL-TRACE TRACING CLOTH - CHARLES BRUNING CO. INC

Richardson County
S-379(4) | 3
Revised

5 | 180 | 5 | 190 | 5 | 200 | 5

Sec. 7-T3N-R15E

Tract 1
Julia A. Noa
SW¼ Sec. 7

176+79.5
50°E ℄

P.I. 182+62.5
Δ = 0°01' Lt.

50°E ℄ 182+77.9

P.I. 189+62.9
Δ = 0°05' Rt.

47.9'S-50°E

Tract 3
Edwin J. Bippes
E½ E½ Sec. 7

1255.2'

598.4'

598.4'

1255.2'

1784.9' Sec. Cor.

720.5'

33'

23.1'

588.9'

115.7'

2°

10'

30'

641.20

134°16'

Mo. Pac. R.R.

45°56

175+39.7 50°E ℄

807.2'

196+94.9
50°S-52.1'E

203+00
100'E-102.7'℄

181+41 - 50°E ℄

182+56.7-40°E ℄
1/4 Sec. Line
182+86.7

Tract 2
Elanor J. Wheeler
NW¼ Sec. 18

STELLA

Tract 4(1)
John H. Stevenson
NE¼ NE¼ Sec. 18

Sec. 18-T3N-R15E

Richardson County
S-379(4) | 4
Revised

5 | 210 | 5 | 220 | 5 | 230 | 5

Sec. 8-T3N-R15E

P.I. 209+48.2
Δ = 1°19' Rt.

46.1'E-50°E

51.1'E-55°E

Tract 5
Robert L. Beckett
SW¼ Sec. 8

2655.1'

2655.1'

2655.1'

651.7'

Cor. 39' Lt. E. Sec. Line
209+50.1 55°E-58.9'E

Tract 4(2)
John Stevenson
NW¼ Sec. 17

Sec. 17-T3N-R15E

Richardson County
S-379(4) | 5
Revised

Sec.8-T3N-R15E

5

Tract 8
Carrie Shefferd
SE¼ Sec. 8

58'E - 55'E
630'E 60'E
237+74.4
63.1'E
241+14.4
43.4'E
244+79.4
43.7'E
246+28.9
108.8'E - 105'E
248+87.9
54.0'E - 50'E
55.0'E - 50'E
70.0'E - 65'E
169.2'
34.06'
365.0'
163.5'
269.3'
2658.5'
959.2'
1375.8'
1329.3'
388.8'
389.2'
794.8'
164.7'
687.9'
665.6'
55'E - 52'E
80'E - 77.0'E
236+052
244+00
80'E - 76.4'E
245+64.4
90'E - 86.3'E
Ho.
1/16 Sec. Line 86.0'E
247+34.4 65'E - 61.0'E
256+00
120'E - 115.5'E
Sec. Line 70'E - 65'E
262+63.7 65'E

Tract 30
Noel Anderson
W½NE¼ Sec. 17

Tract 7
Harley Mason
E½NE¼ Sec. 17

Sec. 17-T3N-R15E

5 270 5 280 5 290

Richardson County
S-379(4) | 6
Revised

Sec. 9-T3N-R15E

P.I. 286+52.9
65'E - 68.5'E Δ=0°10'Lt.
528'E - 50'E
62.8'E - 60'E
289+20.1
60.5'E - 60'E
294+50
71.3'E - 70'E
939.3'
1328.2'
939.8'
530.0'
80'E
76.5'E
Born
1/16 Sec. Line 55'E - 52.2'E
275+91.9 70'E 67.2'E
1/4 Sec. Line
80'E - 59.5'E

Tract 8(1)
Nevada H. Young
S½SW¼SW¼ Sec. 9

Tract 9(1)
Nellie M. Steadman
SE¼SW¼ Sec. 9

Tract 10A
Phillip McMullen
W½SE¼ Sec. 9

Tract 8(2)
Nevada H. Young
W½NW¼ Sec. 16

Tract 9(2)
Nellie M. Steadman
E½NW¼ Sec. 16

Tract 10
Phillip McMullen
W½NE¼ Sec. 16

Sec. 16-T3N-R15E

Richardson County
S-379(4) | 7
Revised

5 | 30 | 5 | 31 | 5 | 32 | 5

SEC. 9-T3N-R15E

SEC. 10-T3N-R15E

Tract 10A
Phillip McMullen
W½ SE¼ Sec. 9

68.7'S - 69.2'E
302 + 49.9

House

Tract 10B
Richard McMullen
E½ SE¼ Sec 9

645'E - 60'E
74.5'S - 70'E
315 + 79.8

Tract 12
Effie Steadman
W½ SW¼ Sec. 10

799.9'
1329.8
1329.8
1329.9'
1329.9'
1329.9'
1310.2
1310.0
1310.0

Ho.

45'E - 47.5'E
1/16 Sec. Line

50'E - 45.5'E
60'E - 55.5'E
Sec. Line

Tract 10
Phillip McMullen
W½ NE¼ Sec. 16

Tract 11
Velma F. McMullen
E½ NE¼ Sec. 16

Tract 13
Charles B. McMullen
NW¼ Sec. 15

SEC. 16-T3N-R15E

SEC. 15-T3N-R15E

Richardson County
S-379(4) | 8
Revised

5 | 330 | 5 | 340 | 5 | 350 | 5

SEC. 10-T3N-R15E

Tracts 14(1) & 14 Supp.
Carrie S. Baker
E½ SW¼ Sec. 10

334 + 00
126.5'E - 125'E

P.I. 336 + 44.9 Δ = 0°07'R
76.1'E - 75'E

338 + 00
125.5'E - 125'E

341 + 99.9
49.0'E - 50'E

Tract 14(2)
Carrie S. Baker
SE¼ Sec. 10

52.3'E - 50'E
328 + 89.9
1/16 Sec. Line

400.3'
755.5'
1310.1'
555.7'
2620.2'
2620.1'
400.0'
399.9'
2621.0'
755.0'
555.0'
1807.8'

48.9'E
50'E

60'E - 57.7'S
50'E - 47.7'S

50'E
50'E - 51.0'S
¼ Sec. Line

Tract 15
Antonio C. Nanfito
N½ NE¼ Sec. 15

S-379(4) | 4

Revised

SEC. 10-T3N-R15E

SEC. 11-T3N-R15E

Tract 14(2)
Carrie S. Baker
SE¼ Sec. 10

Barn

House

EQUATION
368+21.0 · S-379(4)=
371+23.5 · S-288(2)

368+21.0
52.5'S - 50'E

Tract 16
Donald Bright
W½SW¼ Sec. 11

381+40.7 1/16 Sec. Line
54.9'S - 50'E

1319.7'

1319.7'

2639.5' to 1/4 Cor.

2386.9'

721.4'

120.7'

90.2'

40'

40'

91.3'

℄ Along Old R.O.W.

Pl. 360+07.3
Δ = 0°59'Lt.
50'E-41.8'S

367+28.3 48.7'S

367+81.0 120.6'S

℄ Sec. Line
1232'E

368+61.0 120.8'S

369+20.9 51.9'S

Tract 15
Antonio C. Nanfito
N½NE¼ Sec. 15

Tract 18
Theodore J. Yoesel
N½NW¼ Sec. 14

SEC. 15-T3N-R15E

SEC. 14-T3N-R15E

Richardson Co.
S-379(4) | 10

Revised

SEC. 11-T3N-R15E

SEC. 11-T3N-R15E

Tract 17
Neil Bright
E½SW¼ Sec. 11

Pl. 393+07.9
Δ = 0°16'Rt.
59.1'E - 50'E

57.3'E - 50'E
394+60.5

Tract 20(1)
Florence K. Johnson
S½SE¼ Sec. 11

52.7'E - 50'E 411+29.0
57.7'E - 55'E

1167.3'

1319.8'

152.7'

1667.5'

2639.1'

152.9'

739.6'

1899.6'

45.0'E
50'E

65'E - 57.7'S
℄ 1/4 Sec. Line

402+00
50'E - 44.8'E

Well

Tract 18
Theodore J. Yoesel
N½NW¼ Sec. 14

Tract 19
Theodore J. Yoesel
NE¼ Sec. 14

SEC. 14-T3N-R15E

SEC. 14-T3N-R15E

S-379(4) | 11
Revised

SEC.11

SEC.12-T3N-R15E

Tract 20(1)
Florence K. Johnson
S½SE¼ Sec. 11

Tract 20(2)
Florence K. Johnson
SW¼ Sec. 12

Tract 22
Clyde Rase
Pt. SW¼ Sec 12

SHUBERT

Ho.

Ha

971.6'

55'℄ ℄ Sec. Line 420+99.6

50'℄ ℄ Sec. Line

1020.0'

1020.0'

1100.4'

1100.4'

180.4'

180.4'

54.7'℄-55'℄ 431+19.6

49.7'℄-50'℄

49.7'℄-50'℄ 433+00

33'℄

P.I. 442+73.4
Δ = 0°04' Rt.

℄

Tract 19
Theodore J. Yoesel
NE¼ Sec. 14

Tract 21
William E. Shook
W½NW¼ Sec. 13

432+00
50'℄-50.4'℄

SEC. 14

SEC. 13-T3N-R15E

Richardson Co.
S-379(4) | 12
Revised

℄ R.R. R.O.W.

Tract 23
C.B.&Q. R.R.Co.
Pt. SW¼ Sec. 12

Tract 25
William M. Albin
SW¼SE¼ Sec. 12

Tract 26
Delbert R. Anderson
SE¼ Sec. 12

446+00
49.1'℄-50'℄

49.1'℄-50'℄ 447+48.0

454+08
443'℄-50'℄

462+50
69.6'℄-70'℄

473+04.1
50'℄-50'℄

P.I. 474+08.3
Δ = 0°45' Rt.

148.0'

148.0'

16.1'

16.1'

660.0'

660.0'

842.2'

1054.3'

203.0'

204.8'

1305.1'

1330.1'

1305.1'

1896.0'

1243.5'

1243.5'

445+45
32.2'℄-33'℄

℄ Sec. Line 60'℄-60.9'℄

447+73 60'℄-60.9'℄

60'℄-60.5'℄ 460+78.1

473+21.5
60'℄-60'℄

℄ Sec. Line
P.I. on Sec. Cor. 474+08.3

Tract 24
William J. Ahern
Pt. NE¼ NW¼ Sec. 13

Tract 27
Charles F. Hall
NW¼ NE¼ Sec. 13

Tract 28 & 29
Mary Ellen Sharrer
NE¼ NE¼ Sec. 13

Tract 30
Marvin Morehead