MATCH WITH 44851

(See #44851½)

Stone & Spike · 1173' · Public Road Xing +92.7 · 68+94.4 · Ironbolt · T. 13 N. · HWY NEBR. #66 · ST. T. 12 N.

FURNAS · EUCLID · DAWES · CLAY · BOYD · ADAMS · SILVER · BIRCH · ASH

MILLER & CLARK ORIGINAL ADD.

NICHOLS ADD.

TOWN

FLORA CITY

NORTMAN'S ADD.

PARMELEE'S ADD.

CEDAR

TRACT 1 · TRACT 3 · TRACT 4 · TRACT 10 · CEMETERY

CITY of ASHLAND 4+28.3 & 8" C.I.P. Sani Sewer underxing Contr. ROW 34038 Dated 10-1-59

CITY of ASHLAND 4+13.3 & 8" C.I. Water Line underxing Contr. 34039 Dated 10-1-59

68+83.8 2" Water Line Underxing CITY of ASHLAND Contr. 10-20-58 ROW 33639 8+79 End 46'-24" V.C.P. 11' Lt.

PEOPLES NAT. GAS CO. ℄ 4+37 2" Gas line in 4" casing under xing Contr. Sept 21-59 ROW 34041 Meter 69℄ Lt 44ft. Bend in Line 41.5 Lt. Vent at Bend

4+28.3 M.H. 82' Lt. Dike 3' high 0' above F.R. 5-17-63 45' long 84' long from ℄ Fork

2-#2 telep. Cable O-Xing 15' above telep Line. ℄ Ch. 20.5' Pole 2+83.5' 46.5 Lt.

Corporate Limit

5+96 Xing · 7+32 455' · 23+03.38 · 25+52.06 P.C. · 3°00' C. · BR. 0.91 (2) 1-14 Sp. P.T. 1-35 Sp. P.T. 1-32 Truss. 2-20 Sp. P.T. 1-14 Sp. P.T. 178.54

Xing +01.8 · Xing +76 · 22ND. · 23RD. · 24TH. · 25TH. · 26TH. · 27TH. · 28TH. · 29TH. · 15TH. · 16TH. · 17TH. · 18TH. · 19TH. · 20TH. · 21ST.

3+61 Public Xing 40' Paving · 264' Sold 9-5-46 · 39+33 Xing · 37+029 P.T. Δ = 34° 31' 30" · 34+59.5 ℄ Corporate Limit

T. 12 N. R. 9 E. 2

2660.88' Calc. · 2631.02' Calc. · 2679.41' Calc. · 2692.97' Calc. · 2647.0' · 1869.27' · 1658+01.1 (C.F.S. 1931) · 1939.09 Calc. (A.B.S.) 94+17 · 1646+05 Calc. · 1646+96.14 Calc.

88°0'51" Calc. · 90°50'50" Calc. · 89°26'23" Calc. · 90°50'49" · 89°09'08" Calc. · 88°51'58" Calc. · 91°10'22" Calc.

SALT CREEK

William G. Rogers (W.A. Jonie) 19.0 a (76-49)

C.B.&Q. reserved the right to maintain drainage channel from Sec. 36-15 to Salt Creek when land was sold in 1943

36.13 155'-4"x5' Conc. & Stone Culv. 96'-48' Concr. P. SUBWAY 36.15-20x13'+108.7 Conc. 16'+16' Wood Br. Cvd. 13 paved

Highway Nebr. #63 · 20' Conc. paving · 24' Bituminous Surface HIGHWAY U.S. 6

(85-19) · 77-316 · (99-21) · 14+d

Stone · Spike · Stone

Scale 1" = 400'

MATCH WITH 44036

ASHLAND, NEB. 44035½

MATCH WITH 44035

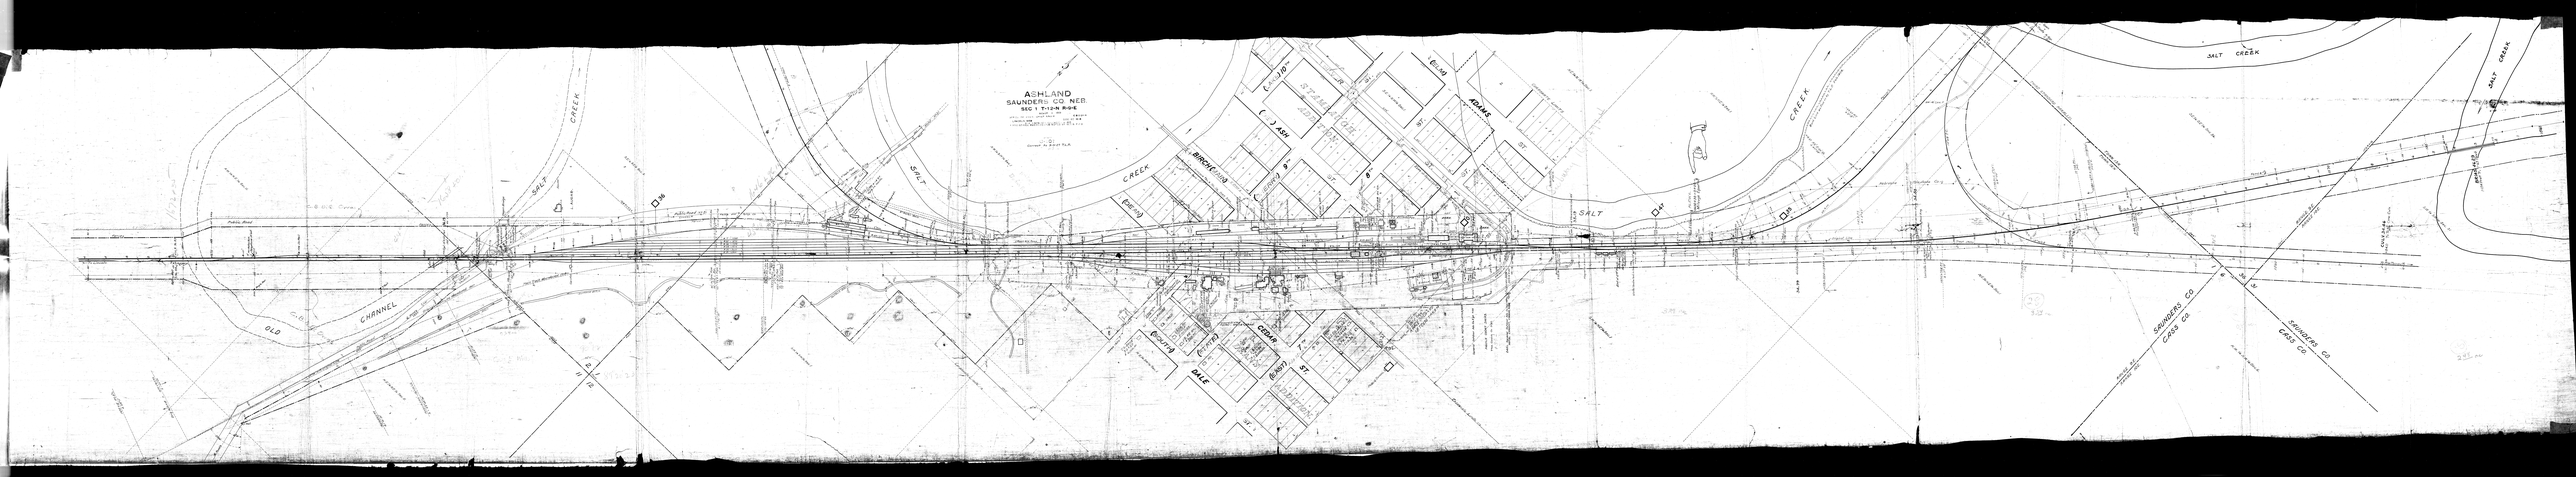
ASHLAND
SAUNDERS CO. NEB.
SEC 1 T12N R8E
SALT CREEK
OLD CHANNEL
BIRCH CREEK
ADAMS
CEDAR
EAST 1ST
DALE
SAUNDERS CO
CASS CO

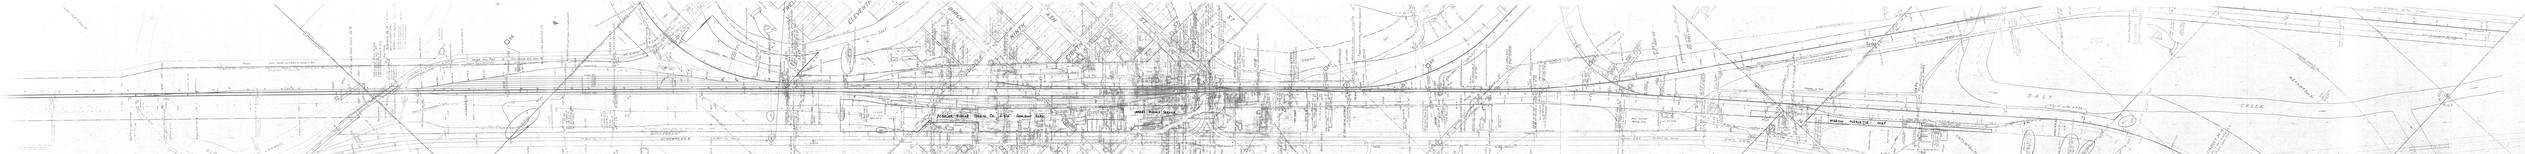
DALY
CREEK

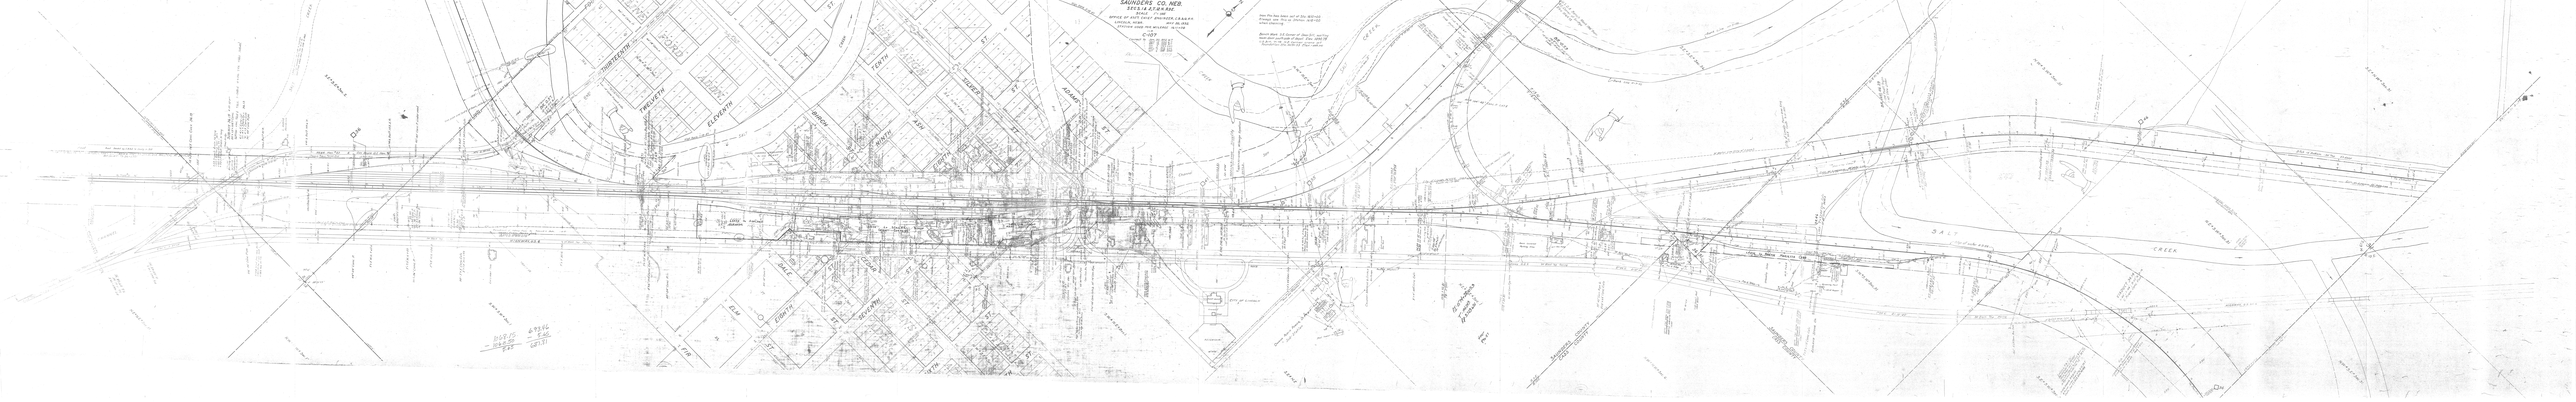
SAUNDERS CO. NEB.
SCALE
1 INCH = 100 FEET
THIRTEENTH ST.
TWELFTH ST.
ELEVENTH ST.
TENTH ST.
NINTH ST.
EIGHTH ST.
SEVENTH ST.
SIXTH ST.
FIFTH ST.
FOURTH ST.
CREEK
SALT
SALT CREEK
RAILROAD
ASHLAND

NEBRASKA

SECTIONS 1 & 2 — T. 12 N. — R. 9 E.

POP. 1,786

DRAWN 4-14-39

SCALE 1" = 400'

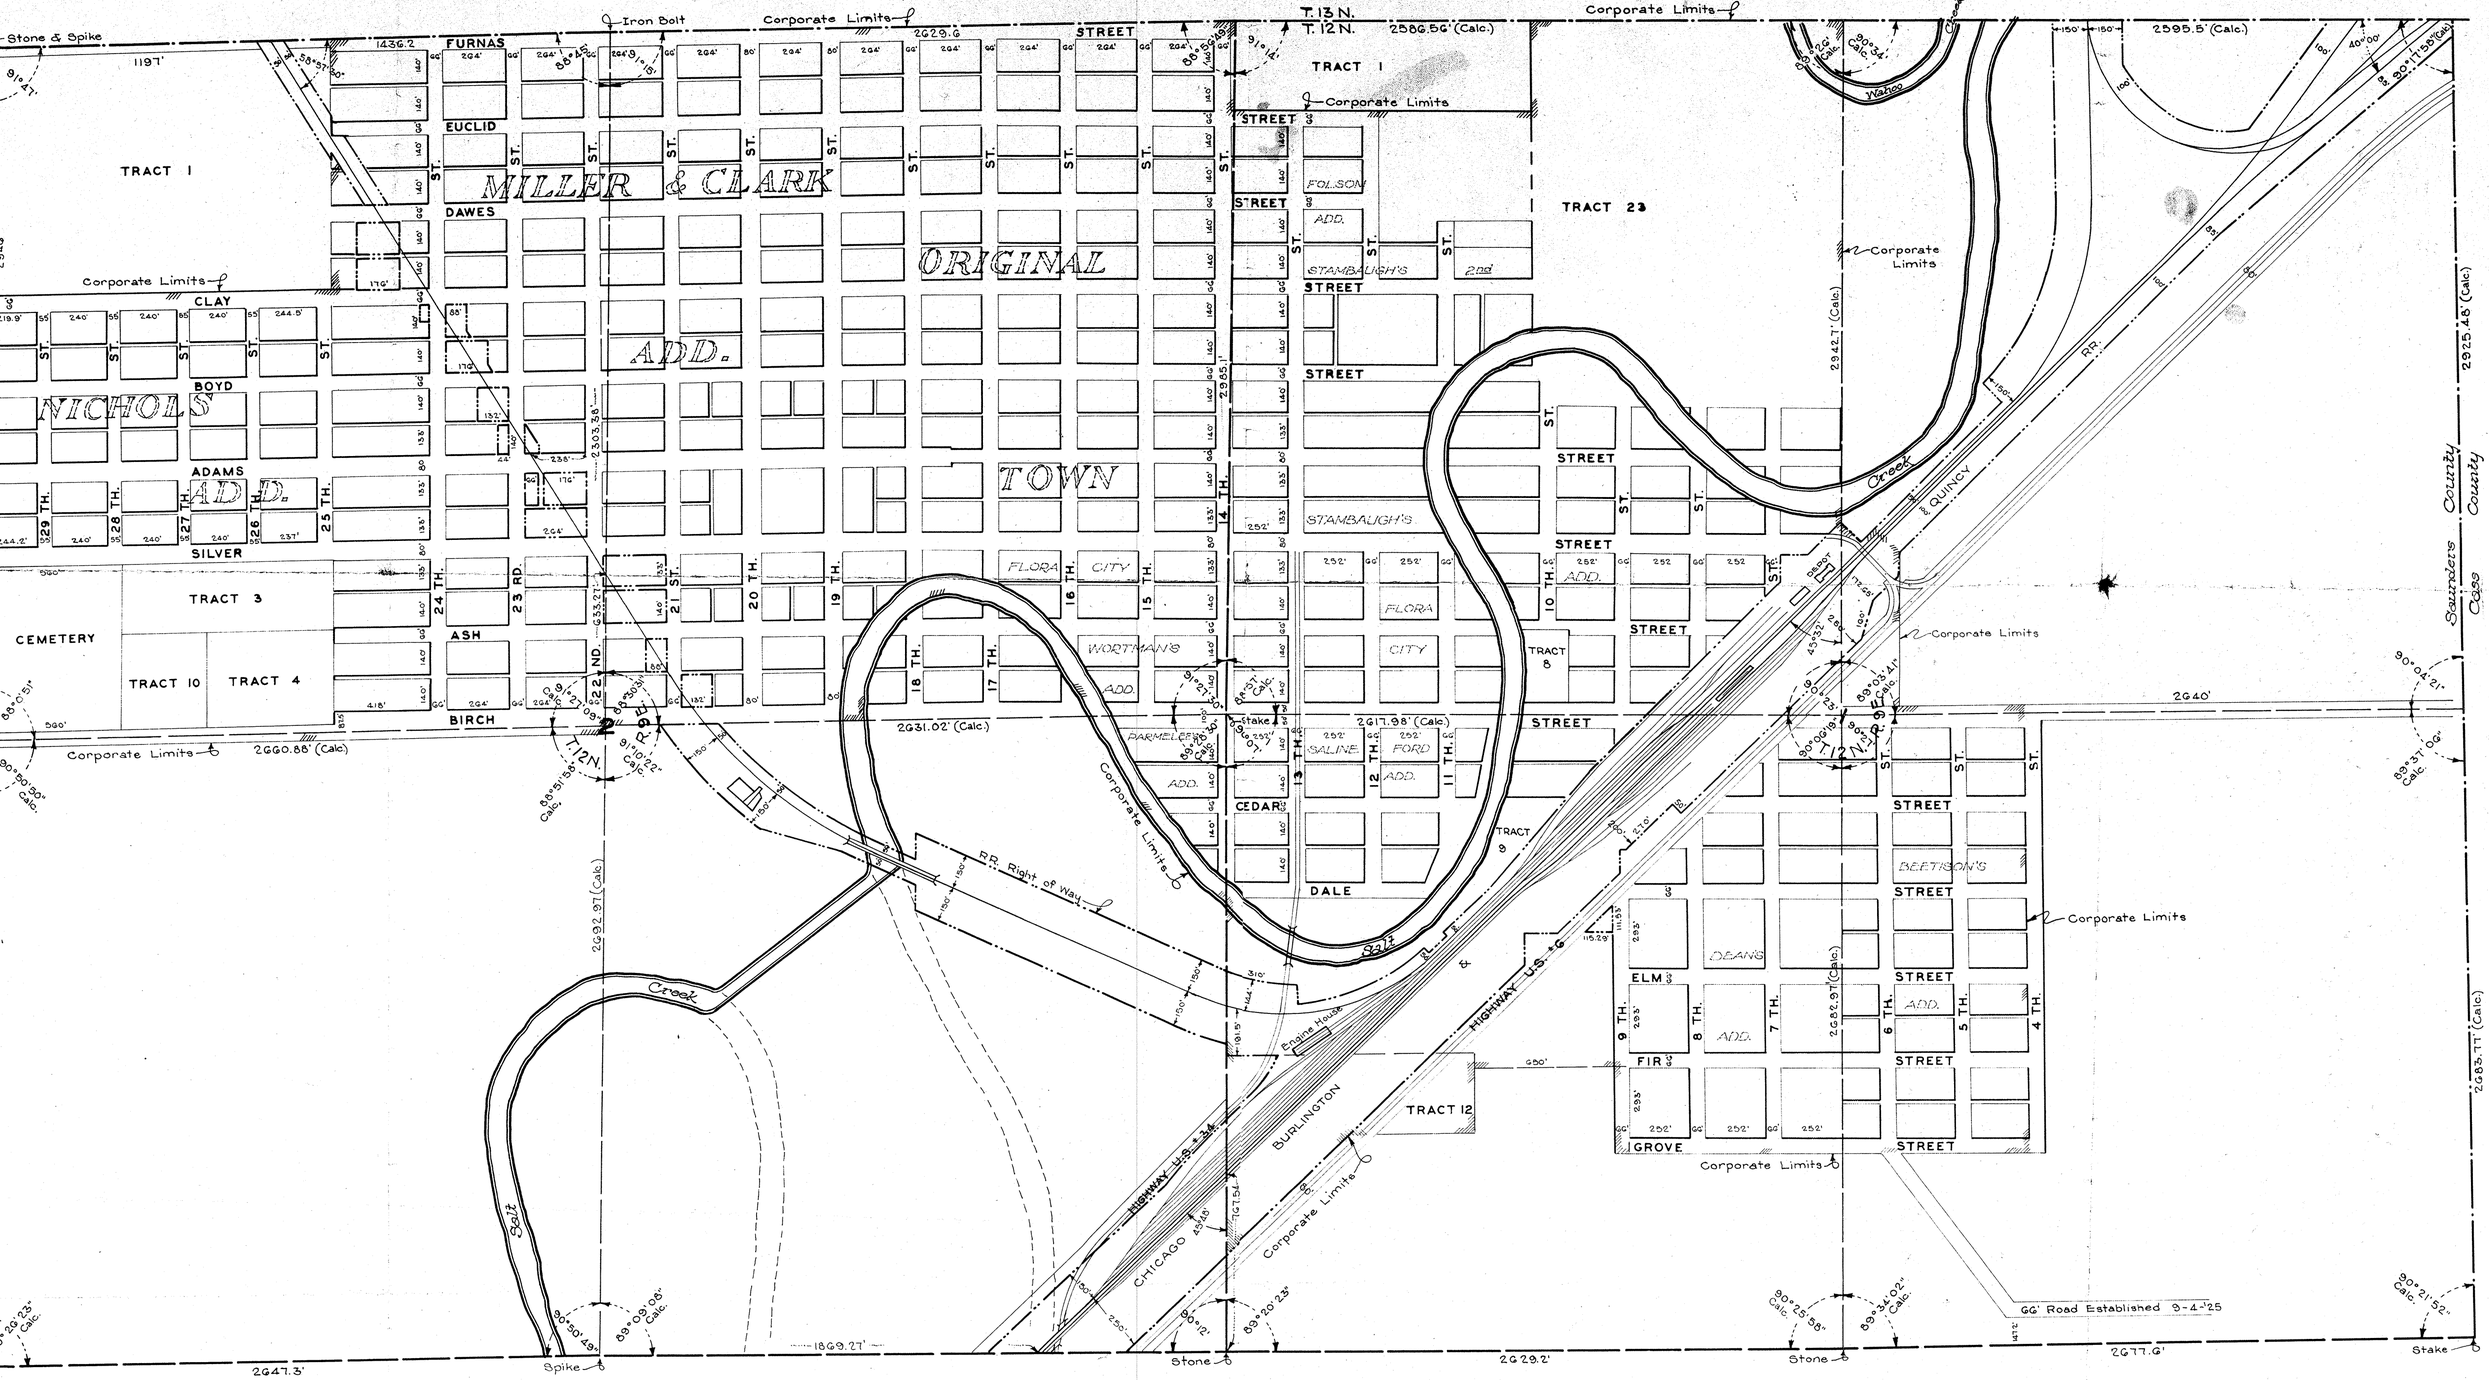

MAP OF
ASHLAND
























































































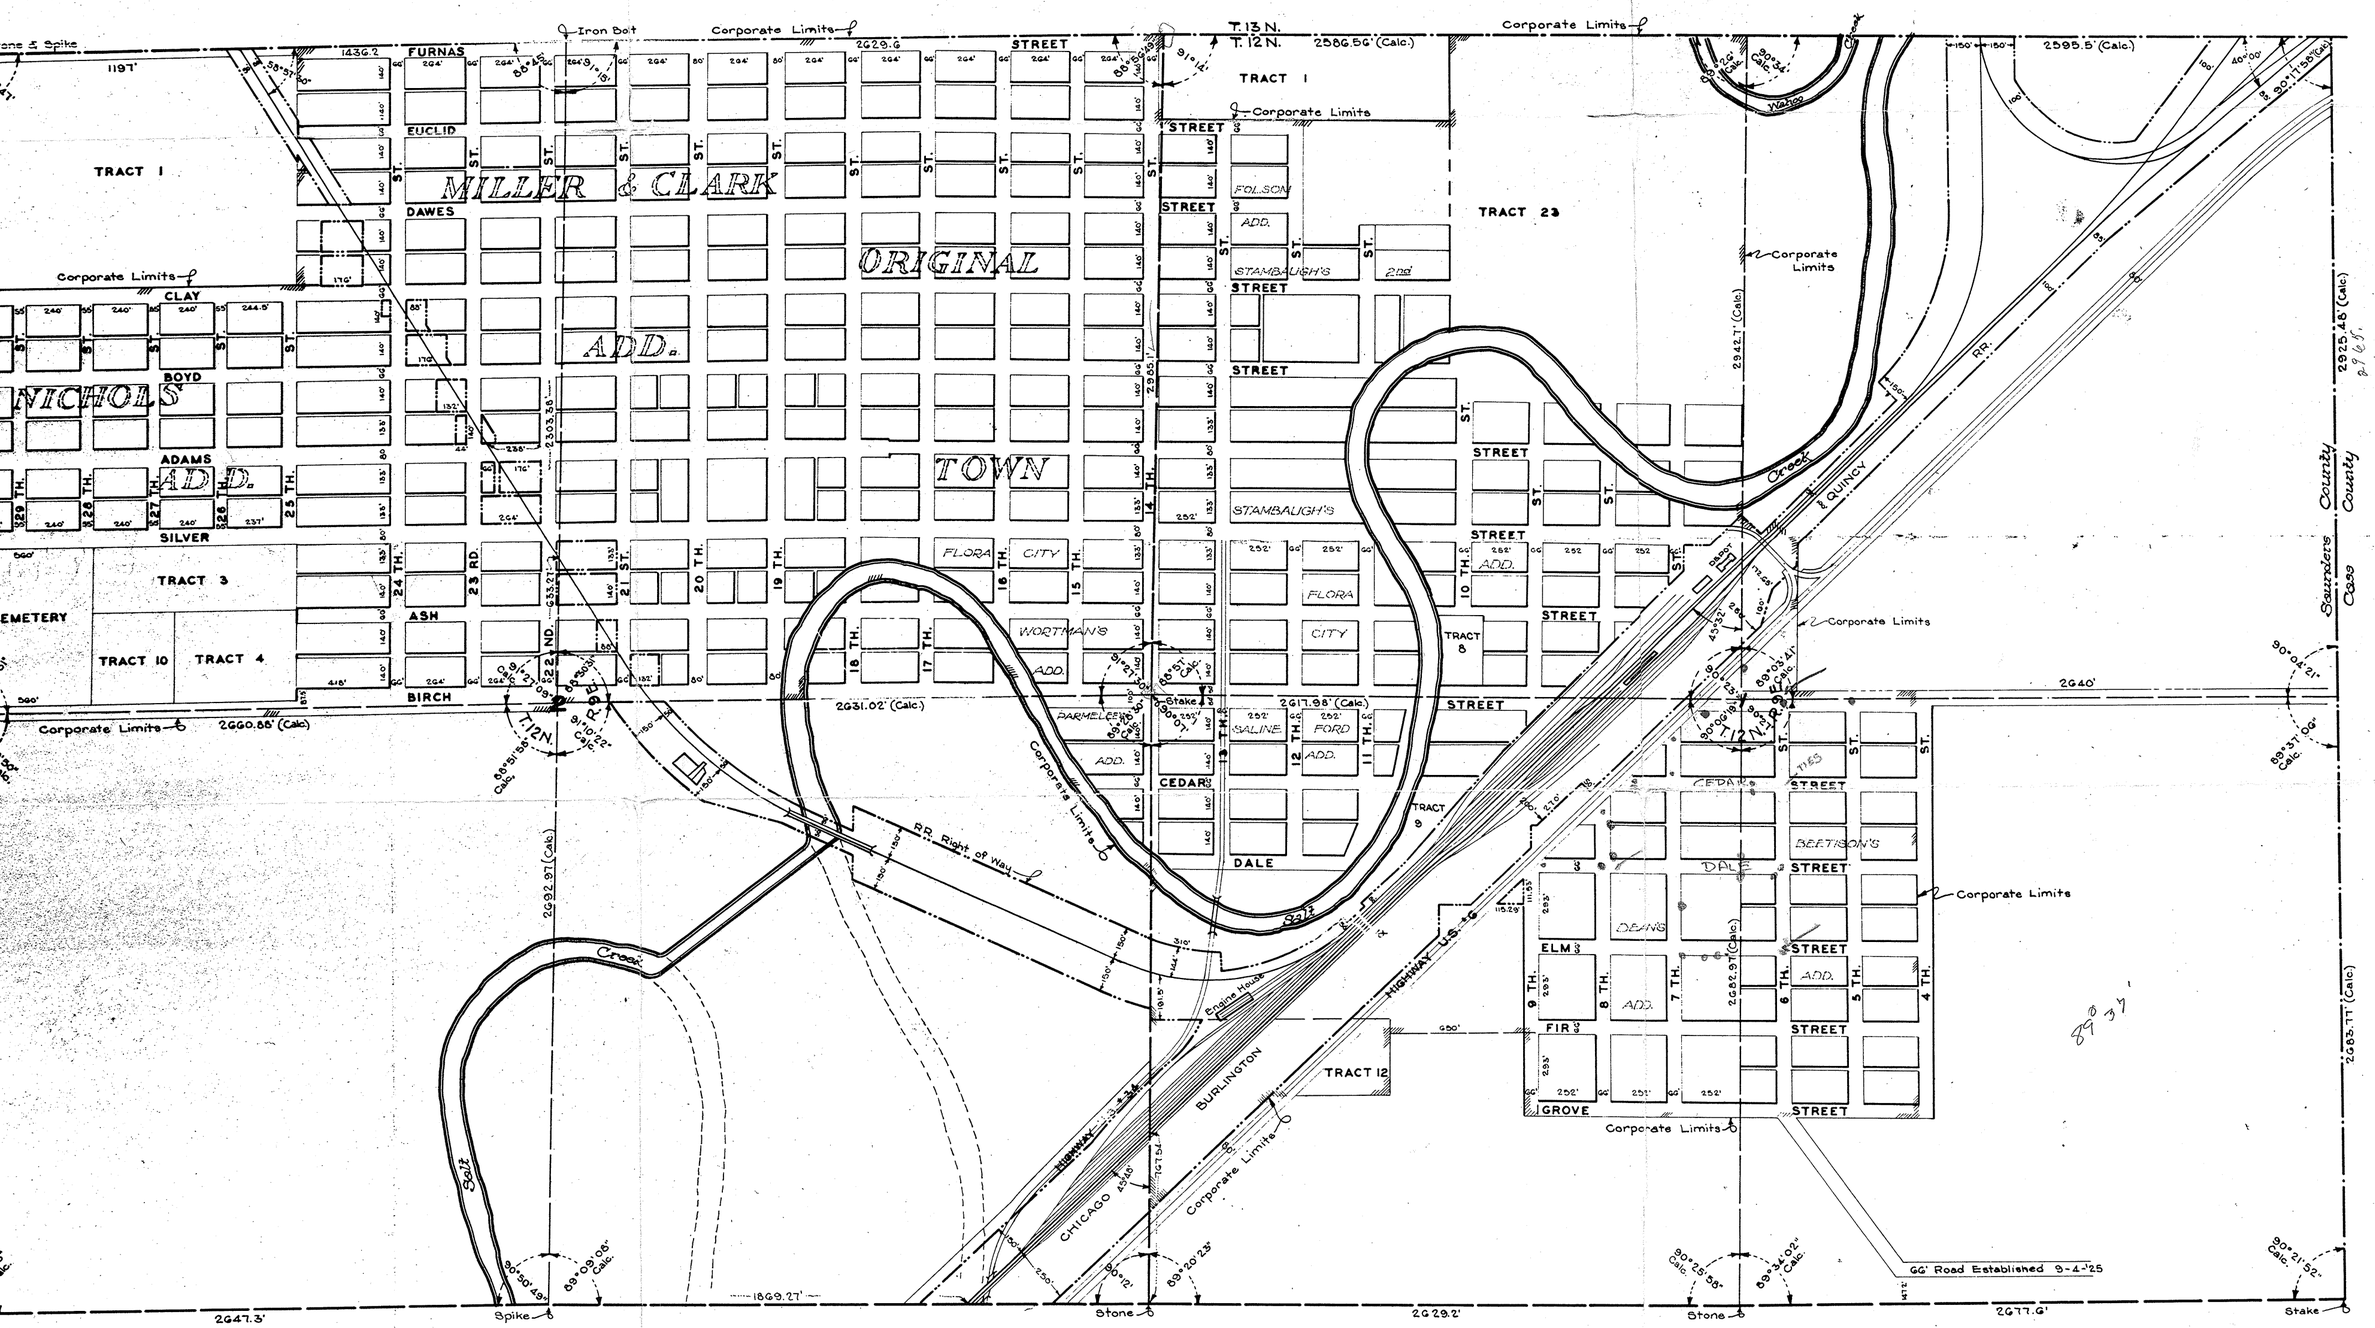

MATCH WITH 45239 IT

3RD STANDARD PARALLEL — T.13N. — T.12N.

ASHLAND
STATION 1611+00

SUNDERS CO.

CASS CO.

MATCH WITH 44035 IT

ASHLAND
44035

Scale 1"=400'

MATCH WITH 44851

pike 1173' Public Road Xing +92.7 68+94.4 Iron bolt T. 13 N. Hwy. Nebr. #66

ST. T. 12 N.

1197' 1436.2' 2629.6' 1204

FURNAS

KENDEL DRIVE

MELRAE ROAD

HEIGHTS ADD.

EUCLID

DAWES

MILLER & CLARK ORIGINAL

CLAY

BOYD ADD.

ADAMS

SILVER

ASH

BIRCH

FLORA CITY HILL

TOWN

FARMERS ADD.

CEDAR

TRACT 3

TRACT 10

TRACT 4

MAP 1+27.8 56+25.8 CIP Water Line ASHLAND Mar. 1975 2x1 E-136

Corporate Limit

SALT CREEK

T. 12 N. R. 9 E.

2660.88' Calc.

2631.02' Calc.

2647.0'

1659.27'

1658.4' Q.U. (C.P.S. 1991)

Scale 1" = 400'

MATCH WITH 44036

ASHLAND, NEB. 44035

(See 44035½)

SALT CREEK

1658+01.1 (CFS 1931)
9+10 - 36.19 - 12'x10'-163' Conc. Culv.

TRACT 2

OLD CHANNEL

4+44.2 Sig. Br.

1660

150'

1670+00

1670

1680

1690

1700

1710

ROAD

Westbound

Eastbound

Fenced

Road Deeded by

+41.5 32'x2' Inst. case
6+31.1 Signal Br.

8+10.7

8+50.2

1819

SALT CREEK

John Peterson Dike 7± high
4 Top 7± high
Pl. Sw.

11561

Battery Well

1591 Battery Well 16.5'L.

132.8 80.75 358.50' Stone

116'36" Conc. Pipe

5'x6.5'x34' Conc. Culv.
5'x6.5'x5'1' Stone Arch

10'x10'-51' Conc. Culv.

Permanent release granted 1943 from flood damages and from maintaining private crossing in north half Sec.11 north of Highway U.S.6.

1686+02 (Orig. line) 1798'

T.12N. R.9E.

37

+85

P.C. 1698+95.13
0°46' C.

P.S. 1695+75.13
Δ=1°13.6'

14.2' Fenced

Δ 6°35.8' I.D. 9°03'
E.C. 1707+35.57

14.2' Δ 1°13.6'
P.T. 1710+75.57

+64.8 Battery Well

5'x2.3 W. Yard Limit 11.6'L.

1720

City of Lincoln 36" C.I.P. Water Line

HIGHWAY U.S. 6

24' Black Top Paving

1720 Cont. 10-13-31

Main Track Abandoned 1918

1696+93 (Orig. line)

70.5'

40'

SAUNDERS COUNTY
CASS COUNTY

Scale 1" = 400'
HDP 1-22-41

44036

SAUNDERS COUNTY
CASS COUNTY

(See 44036½)

Stone

950.2'

1730+02

359.6'

Stone

53° 21'

100'

100'

Sold Q.C.D.
dated 10-17-49

Const. 1938

Ditch

Main line abandoned 1918

Ballwall 11.5±

36" x 36" Conc. Pipe

44+59

1745+90.9

38=37.97

1750

1750

18" x 36" Pipe Culv.

54+13

1752+17.6 = 1754+00 (Orig. line)

1760

12' x 8' x 34' Conc. Box Culv.

15

T. 12 N. R. 9 E.

100'

50'

Public Road Overpass Br 38.15

1770

50'

U.S. 6 HIGHWAY

Eastbound

Eastbound

1768+46

1780

42°

City of Lincoln 36" CIP Water Line Const 1973-74

Private Road Xing #17

1790

50'

53° 24'

SUBWAY 38.77
94+70-18'x13'-43.6 Skew
V.C.I. 13' Paved

1795+25

Scale 1" = 400'

5+47.3 ℄ Signal Br 38.77

(See 44037¼)

44037

T 12 N. R 10 E.

PLATTE RIVER

Lot 5

Lot 4

Lot 3

Lot 2

Lot 1

280

290

Base 1950

Bank Line J 52.45

Bank Line 1950

Scale 1"=100'

T 12 N. R 10 E.

MATCH WITH 44034

SAUNDERS CO
CASS CO

T. 13 N.
T. 12 N.

1508+09
Co. Surveyor's Corner
Stake & County Post

Ditch opened by
Company dragline 1943
5+42 Batt. Well 11.6 L.

75'
75'
50'

1500

1497+53

4'x5' Rail Top Stone Culvert, +73.2
33.41

50'

(See 44037)

75'
50'

3+93.3

#33.30 24'-36" C.I.P.

1490+85.5

1382'

6

T. 12 N. R. 10 E.

Scale 1"=400'

44033

55+30 (R.O.W. Book)

13.8

Fenced

Asbuilt 9 4 Light Flasher-Bell Conte 12-4 Flasher-Wigrate 12-7 Rt. 43+50.2 +28.0R Private Xing State of Nebraska 43+00

City of Lincoln 54"-13,200v Overhead Power Cable Over Xing 10+37.54 Power Pole 3188

Lincoln T.& T. Co. U.G. Xing 20,400v. 20K 3480 & 30 Pr. Co. Cable 43+74.5 E. Edge Last House E/S

Fence (Rod Mk.)

24' Conc. Paving

Rip Rap 1948 AFE 37047

Reinf. rod 83.6' W. of E. ftk & under fence wire

Ditch 10' bottom 30' top 5' deep

21+31 (R.O.W. Book)

Reinf. rod 4.2' S. of E. & W. fence

1298'±

560'±

670.75'

13+10 (R.O.W. Book)

31

T. 13 N. R. 10 E.

sandstone W. Gate Post

and line notes in S.W.¼ by Saunders Cty Engr. 1931 except where noted.

46

Rip Rap 1948 AFE 37047

BR. 34.14 HIGHWAY OVER XING 25' Steel & Conc.

CREEK

Fence

34

Channel - 100' base

SALT

1530

1540

1550

1560

1520

1510

Waste Bank

Corner fence Post 12.3' E. of land line.
























T. 13 N. R. 10 E.

Pipes set by State Hiway

Conc. C/P 34.46 A

Conc. Culv. 33.70

Fenced

Stone 6' W. of 8" Conc. Corner fence post Reinf. rod 6.4' out from and on north side of stone

SAUNDERS CO. T. 13 N.

CASS CO. T. 12 N.

Stone under P.P. Tie 44033.4' (See 44033.4')

Scale 1" = 400

MATCH WITH 44039

44034

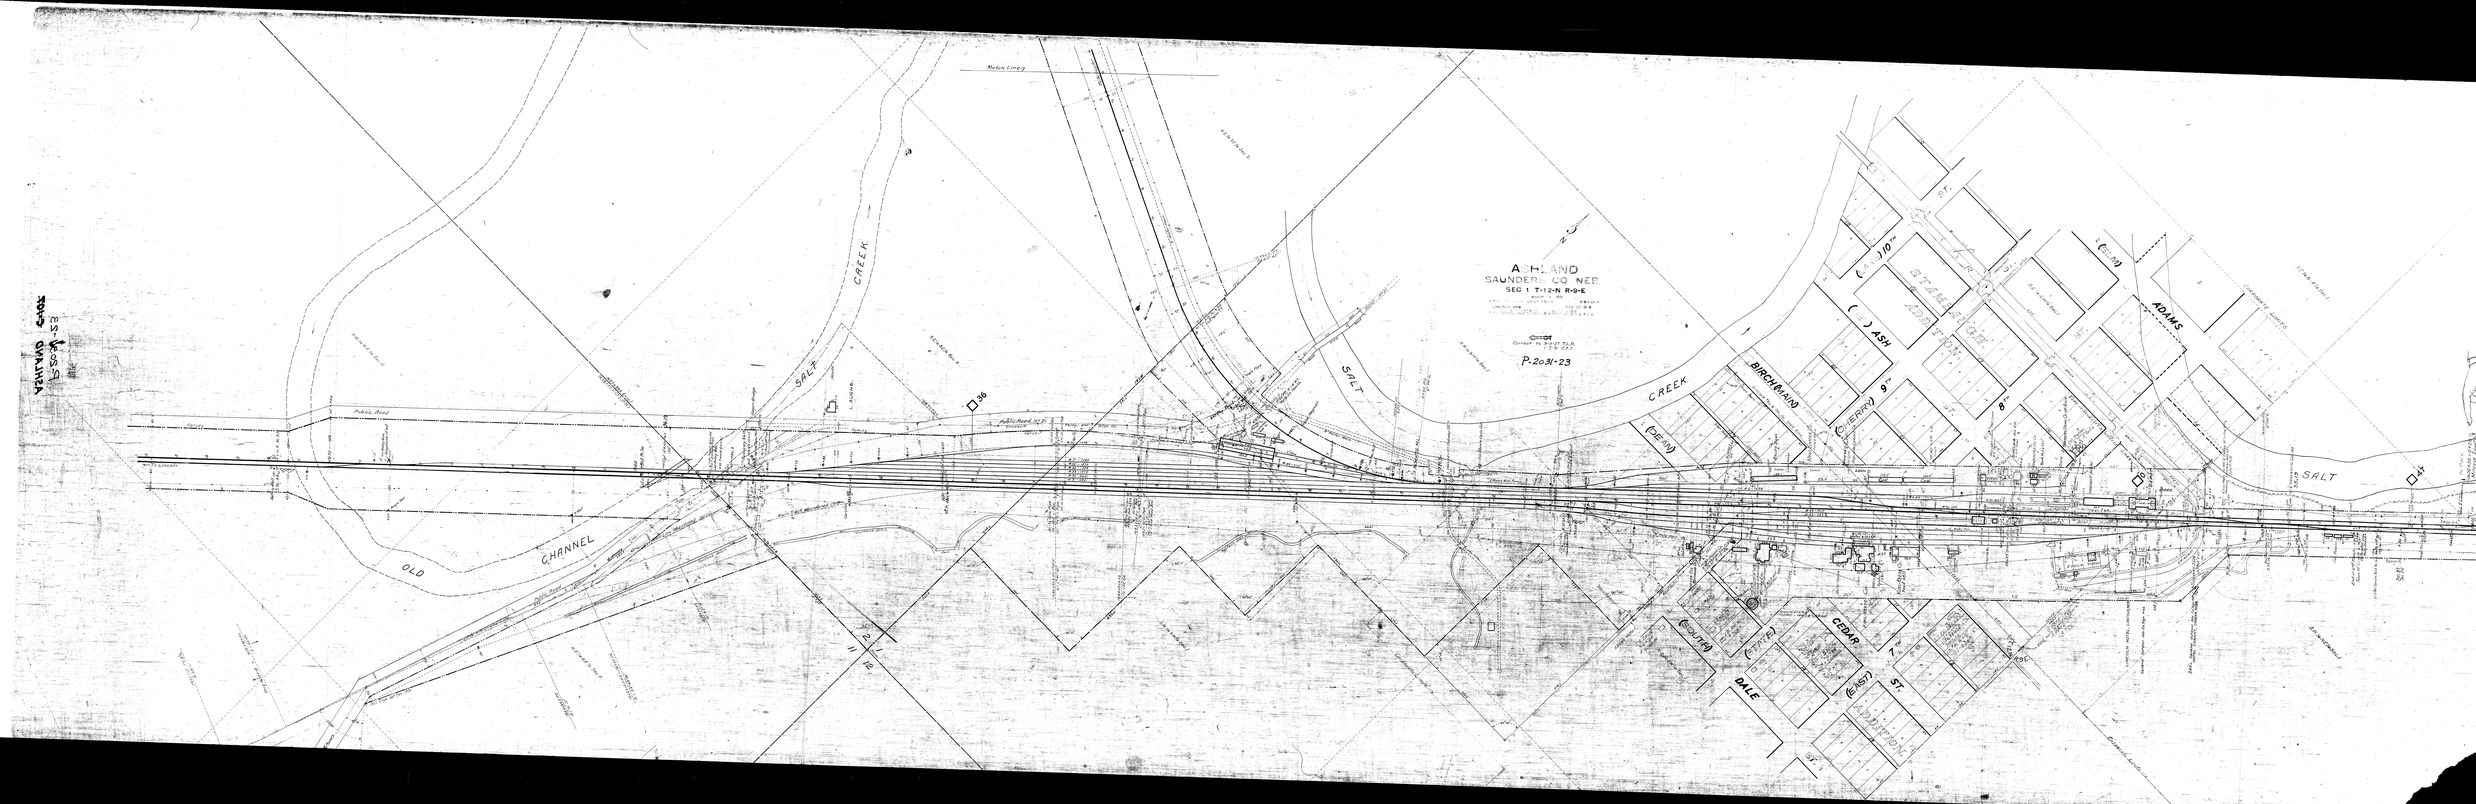
ASHLAND
SAUNDERS CO NEB
SEC 1 T-12-N R-9-E
P-2031-23
SALT CREEK
OLD CHANNEL
Public Road
Public Road 31.5'
Match Lines
BIRCH (MAIN)
CHERRY
ASH
ADAMS
STREET ADDITION
CEDAR
DALE
SOUTH
EAST
7th ST.
8th ST.
9th ST.
10th ST.
ADDITION
N 12 I
R 2 I
36
1
4

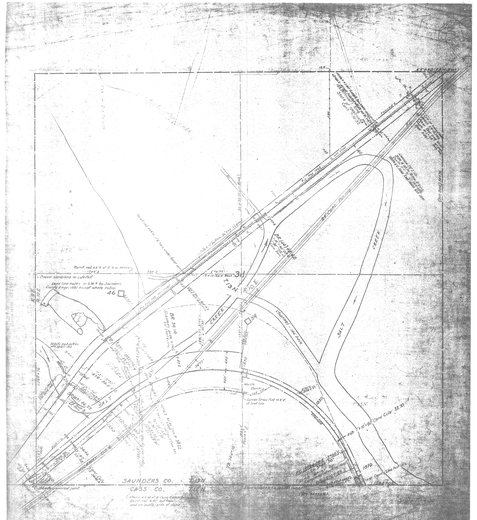
SAUNDERS CO.
CASS CO.
SALT CREEK
WEST
46

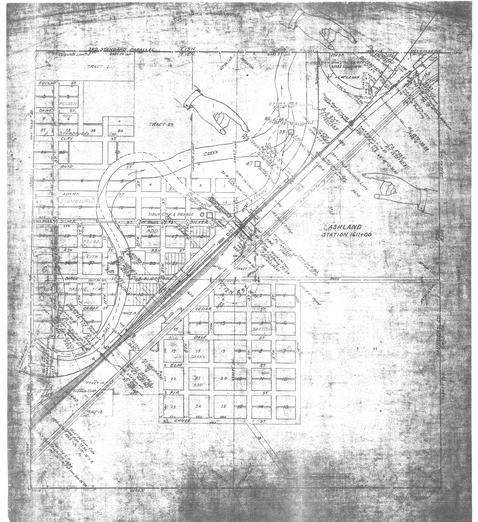
ASHLAND
JUNCTION (RAILROAD)
SALT CREEK
TRACT #3
TRACT #2
TRACT #1
CASS

MILLER & CLARK'S ORIGINAL
VICTORS
ADD.
TOWN
SALT CREEK
WESTERN
TRACT 2
TRACT 3
TRACT 4
TRACT 10
36

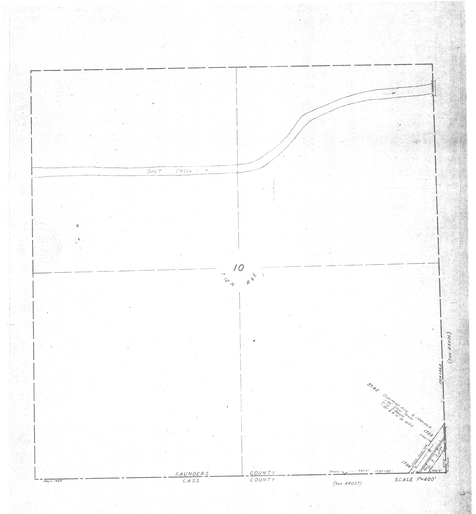
SALT CREEK
10
SAUNDERS
CASS
COUNTY
COUNTY
SCALE 1"=400'

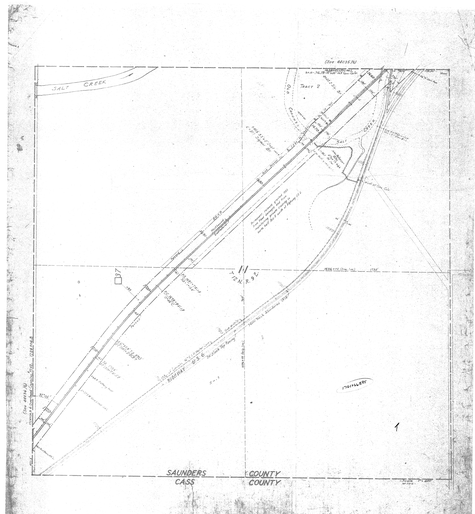
SALT CREEK
11
SAUNDERS
CASS
COUNTY
COUNTY